


T.26S. R.6W.W.M.

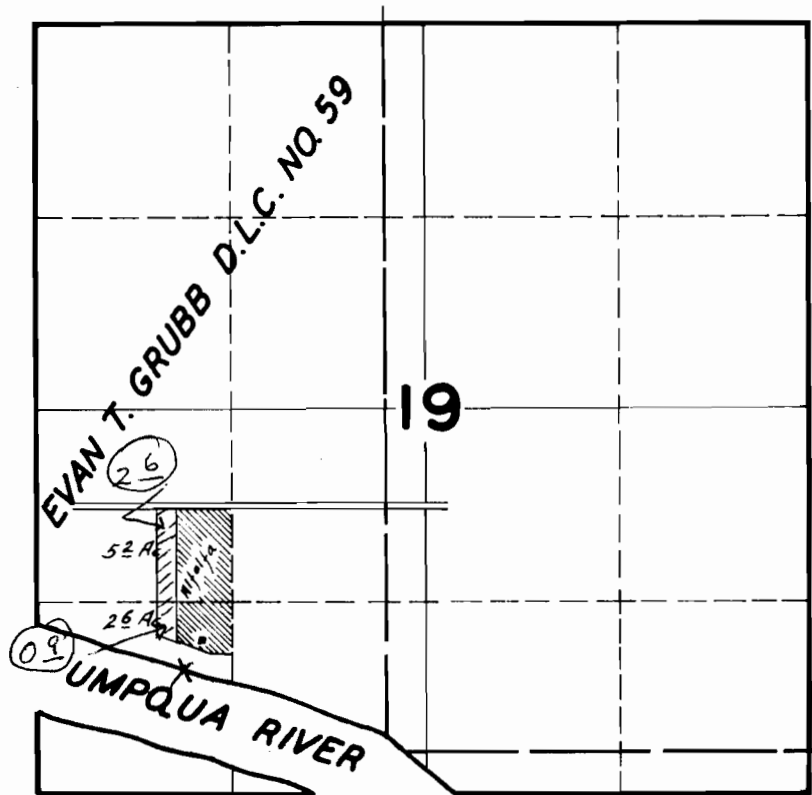

FINAL PROOF SURVEY

UNDER

Application No. 21297 Permit No. 16700

IN NAME OF

E. J. BRODERSEN

Surveyed JULY 11, 1947, by JAS. E. BUNNELL

Elmer Caughron - 12-3151

APP. # 30662
PER. # 24148