


T. 26S. R. 33E. W.M.

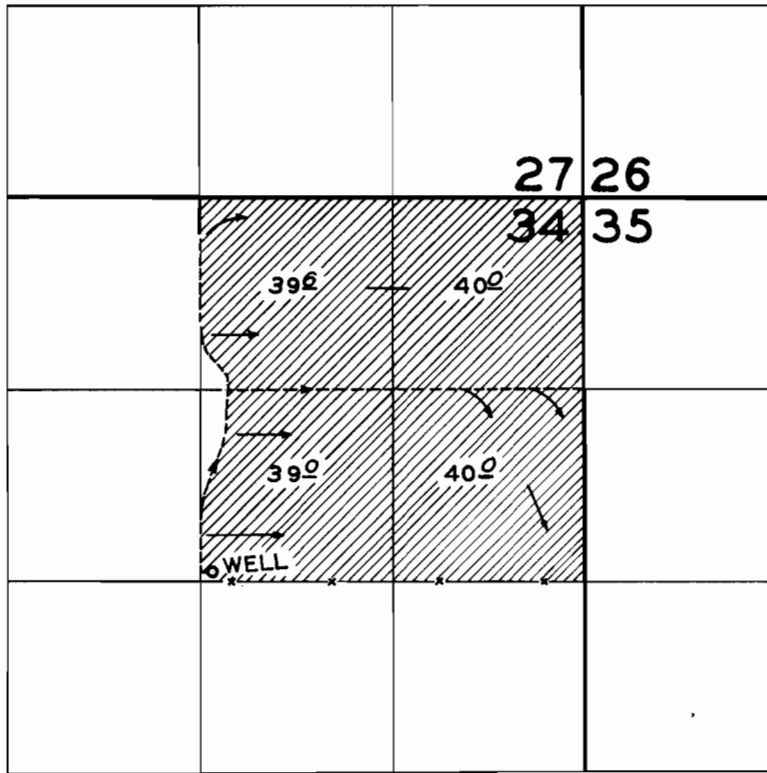

FINAL PROOF SURVEY
UNDER

Application No. U 822 Permit No. U 727
IN NAME OF

E. A. WING

Surveyed OCT. 25 1960, by G.O. BARTELS