


T. 26S. R. 33E. W.M.

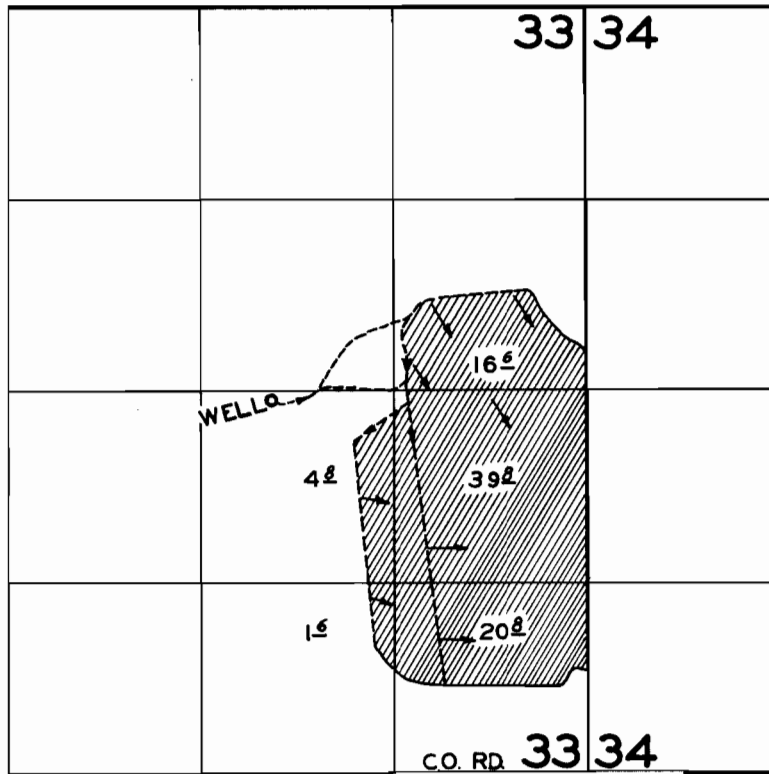

FINAL PROOF SURVEY
UNDER

Application No. U873 Permit No. U757
IN NAME OF

HERBERT C. DAVIS

Surveyed OCT. 25, 1960, by C. O. BARTELS