


T.25S.R.30E.W.M.

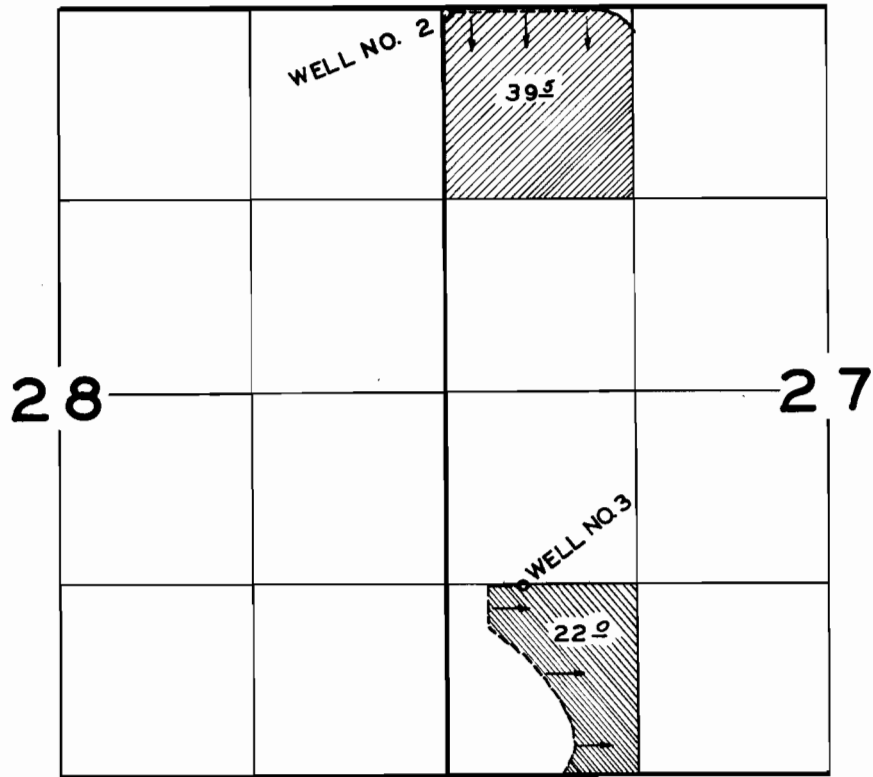

**FINAL PROOF SURVEY**  
UNDER

Application No. G.305..... Permit No. G.362.....  
IN NAME OF

**MARVIN MORGER**

Surveyed OCT. 26, 1960, by C. O. BARTELS.