


T.26S.R.36E.W.M.

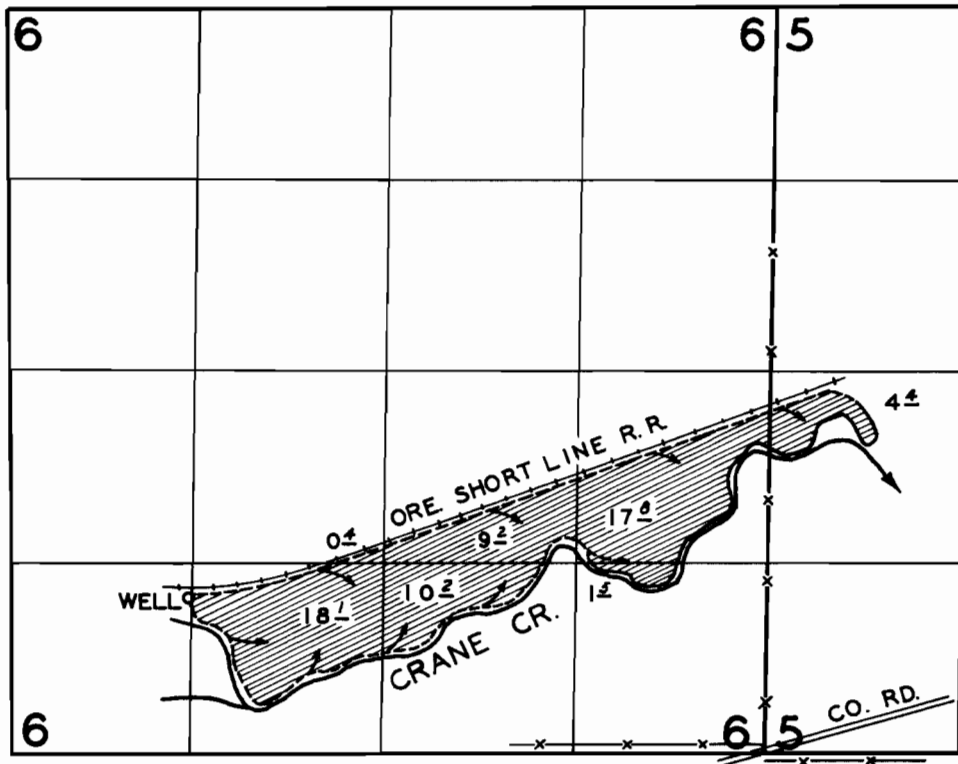

FINAL PROOF SURVEY
UNDER

Application No. G 314 Permit No. G 386
IN NAME OF

DAN OPIE

Surveyed OCT. 25 1960, by C. O. BARTELS