


T. 28S. R. 35E. WM.

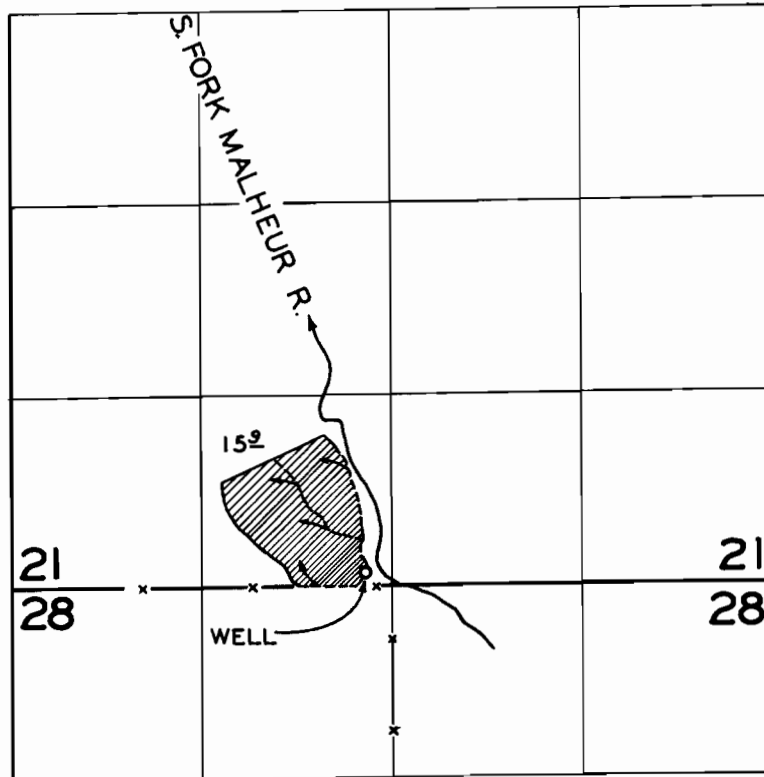

**FINAL PROOF SURVEY**  
UNDER

Application No. G.312..... Permit No. G.41.5.....  
IN NAME OF

**TOM JENKINS & ADELE PAUL**

Surveyed OCT. 25, 1960, by C.O. BARTELS.....