


T.23S.R.3E.W.M.

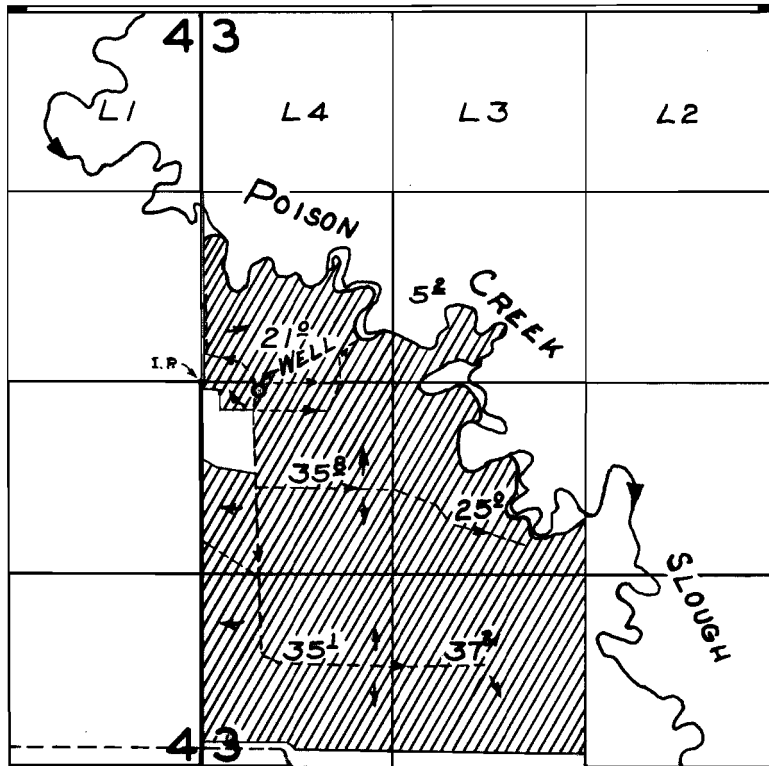

**FINAL PROOF SURVEY**  
UNDER

Application No. G-1345 Permit No. G-1213.....  
IN NAME OF

JOHN V. & WILHELMINA SCHECKEL

Surveyed OCT. 22 1960, by [Signature]