


T.23S.R.32E.W.M.

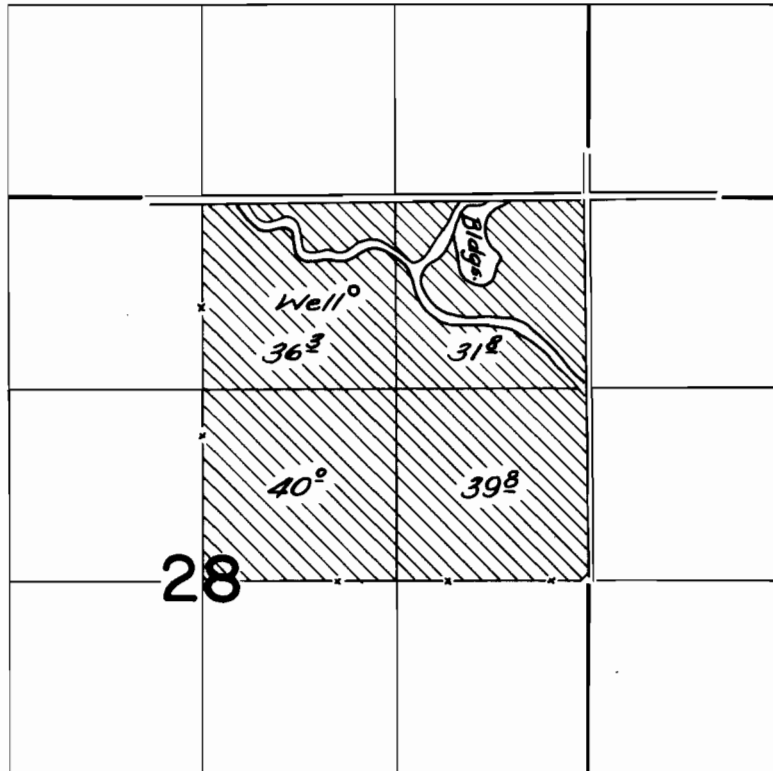

FINAL PROOF SURVEY
UNDER

Application No. *G-1385*... Permit No. *G-1273*...
IN NAME OF

L. L. JACOBS

Surveyed *Oct. 25* 19*60*, by *C. D. Baile*