


T. 25S. R. 29E. W.M.

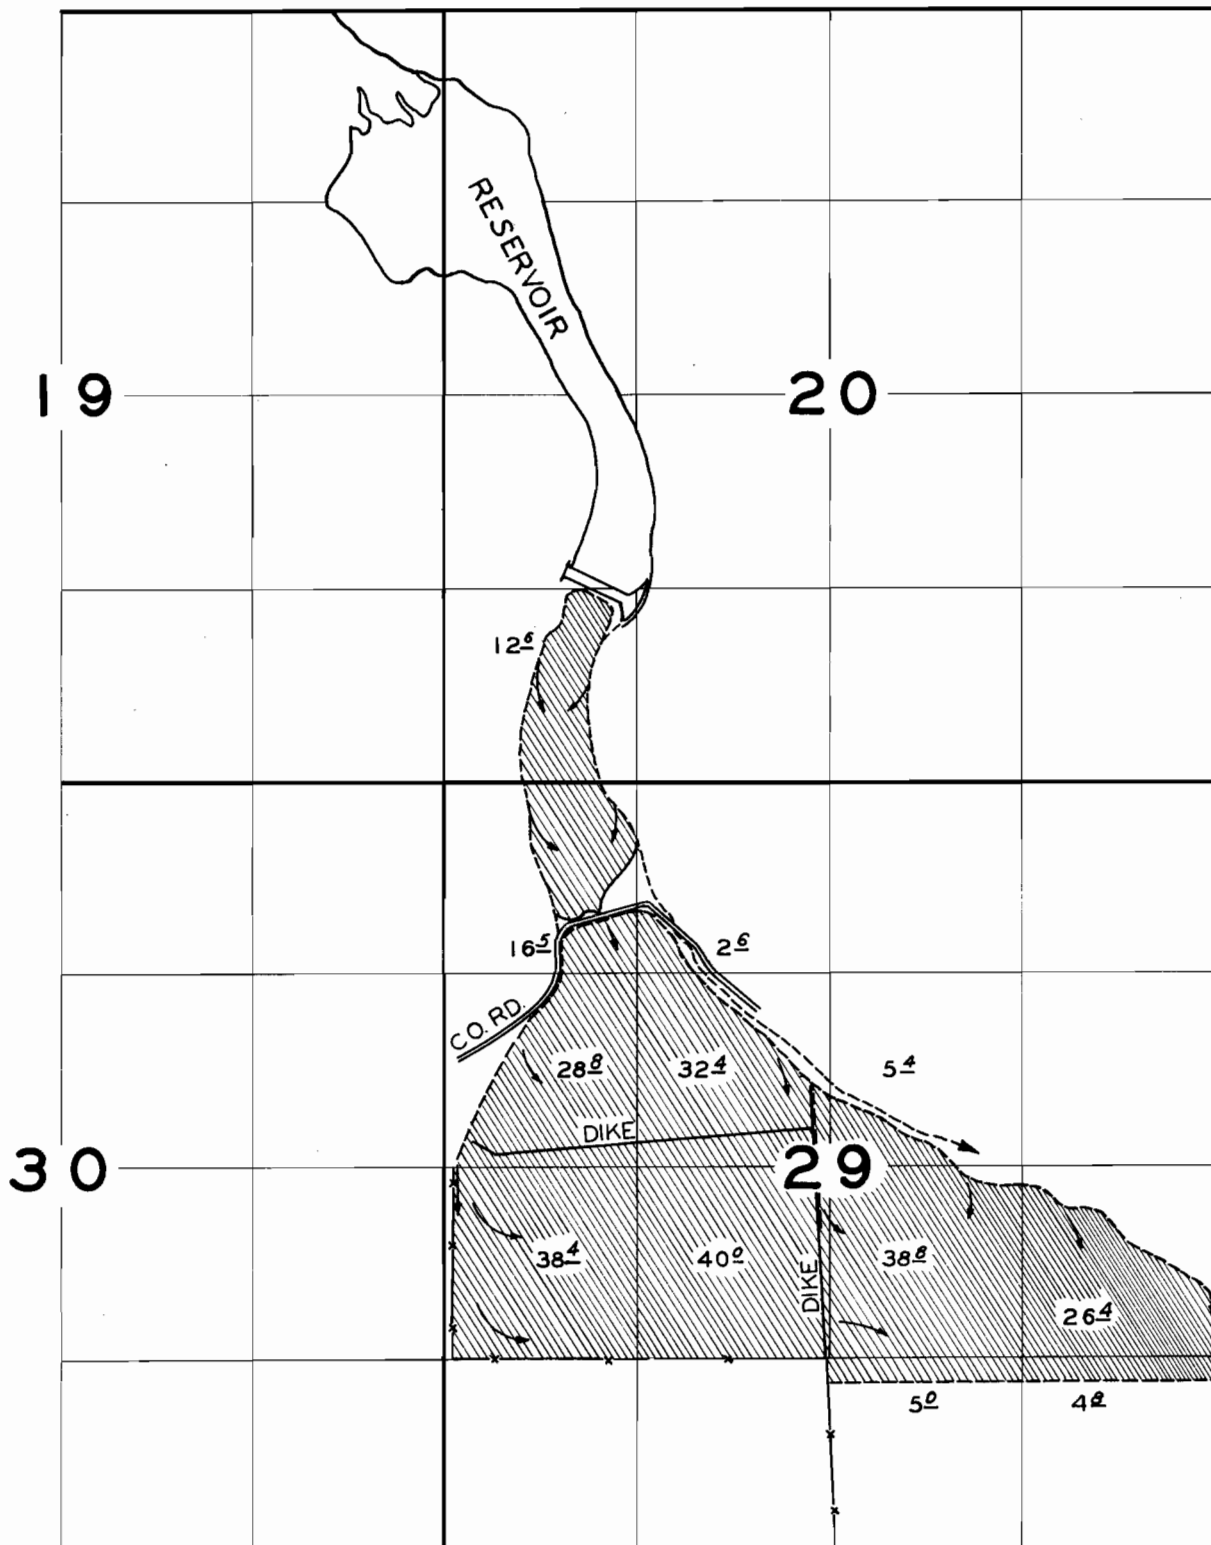

FINAL PROOF SURVEY
UNDER

APPLICATION NO. R29764 PERMIT NO. R1747
27927 23572

IN NAME OF

A.A. & ALVIN HURLBURT

SURVEYED OCT 24, 1960 BY C.O. BARTELS