


T.22 S. R. 30 E. W.M.

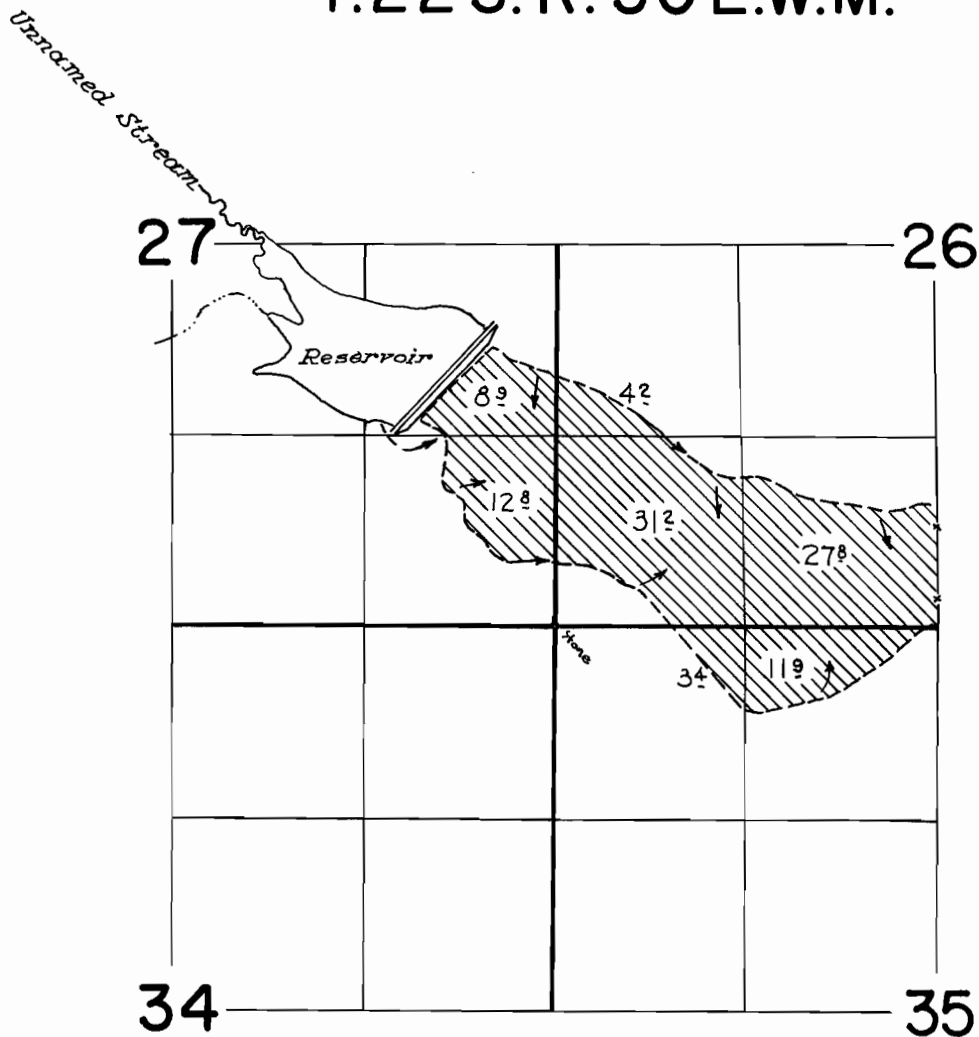

FINAL PROOF SURVEY
UNDER

R-31594 R-2026
Application No. 31595 Permit No. 24922
IN NAME OF

WERNER W. ARNTZ

Surveyed Oct. 20 1960, by

[Signature]