


T.2N.R.10E.W.M.

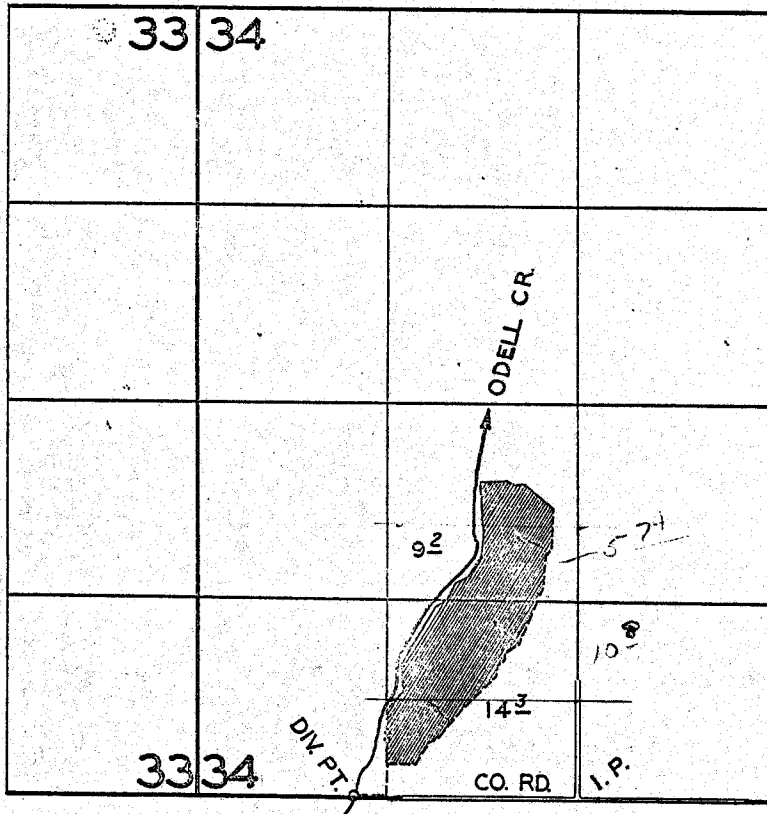

FINAL PROOF SURVEY
UNDER

Application No. 32104..... Permit No. 25332.....
IN NAME OF

.....CLAUD E. COATS & SON.....

Surveyed NOV. 1..... 19.60., by C. O. BARTELS.....

A