


# T.2N. R.10E.WM.

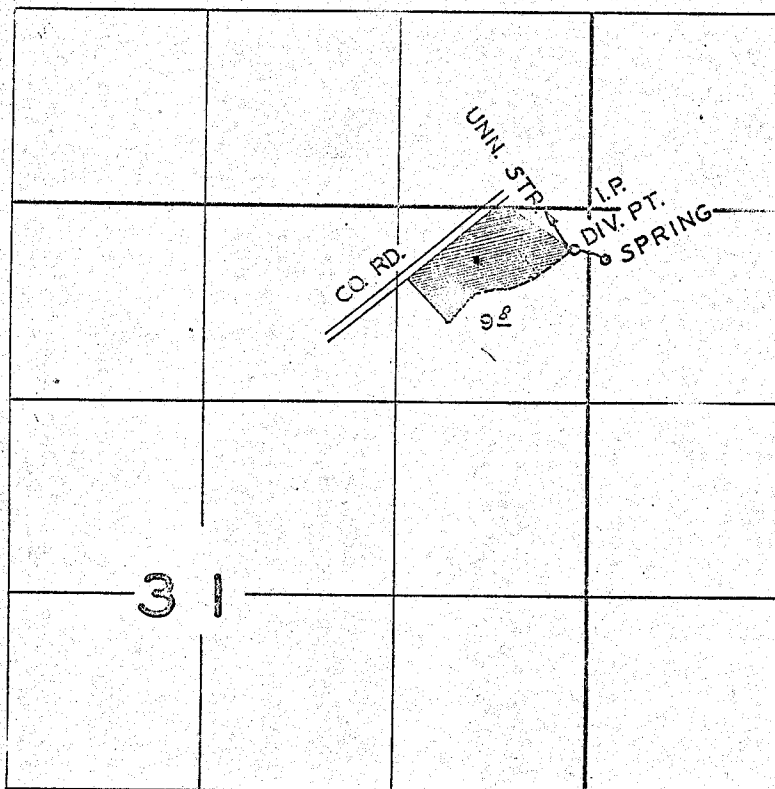

## FINAL PROOF SURVEY UNDER

Application No. 32180..... Permit No. 25387.....  
IN NAME OF

E. J., WILMA & MYRTLE GERARD

Surveyed NOV. 3 19.60. by C. O. BARTELS