


T. 36 S. R. 2 W. W.M.

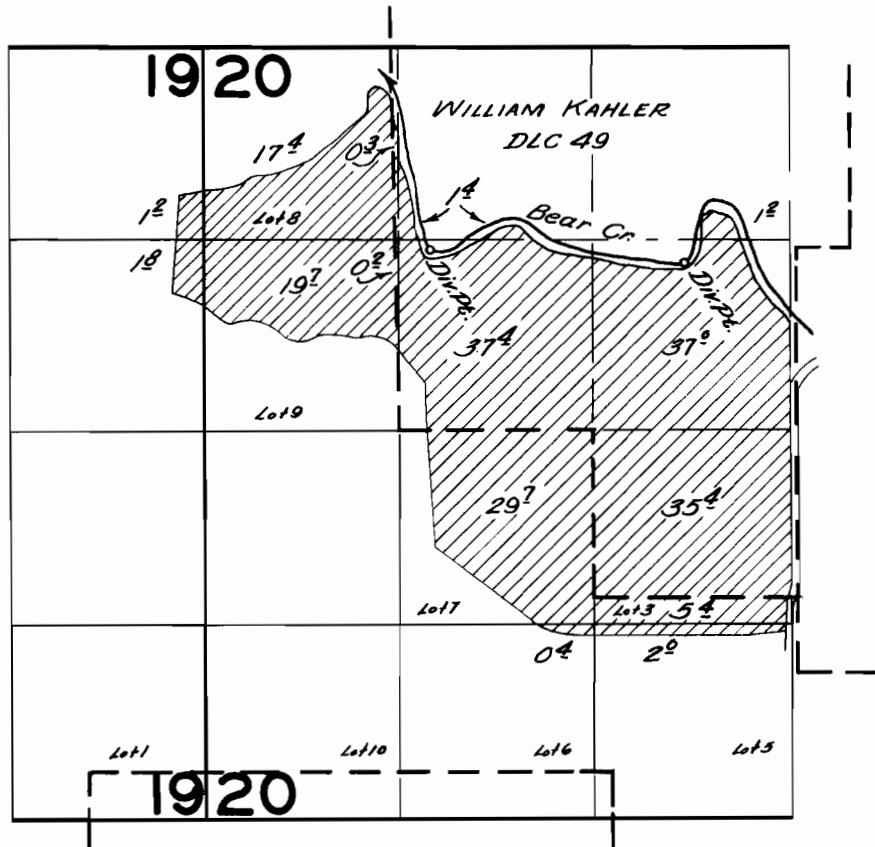


FINAL PROOF SURVEY
UNDER

Application No. 24461... Permit No. 19282...
IN NAME OF

T. R. PARKER

Surveyed April 13 1960, by Coartels

T.36S. R.2W.W.M.

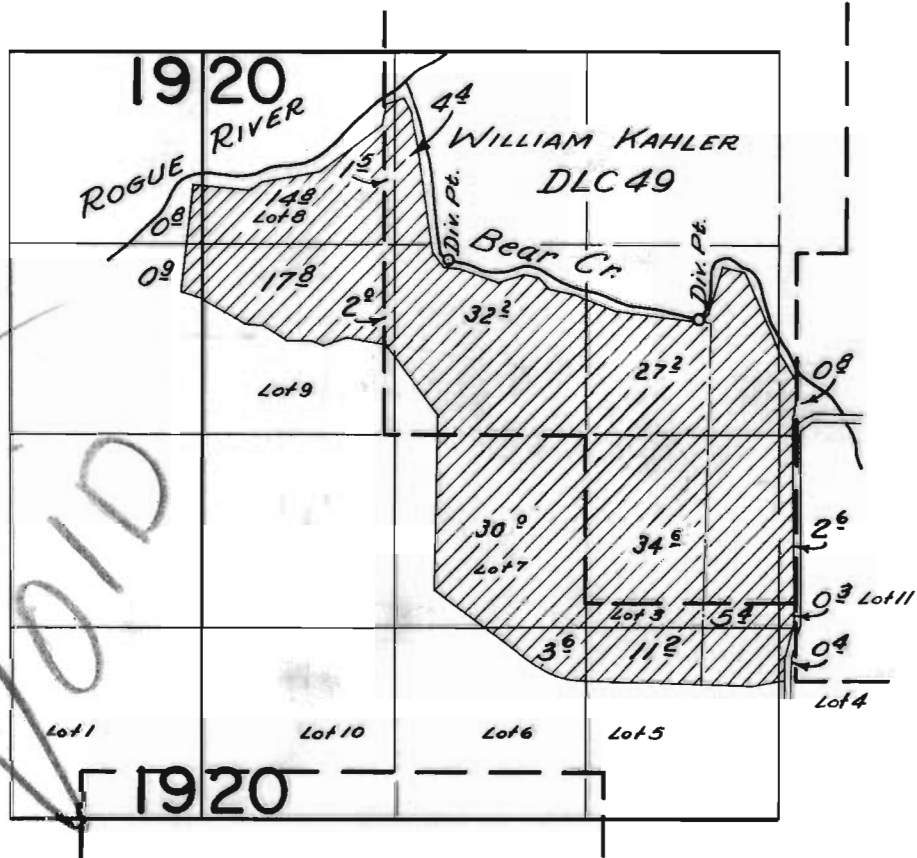

FINAL PROOF SURVEY
UNDER

Application No. 24461... Permit No. 19282...
IN NAME OF

T. R. PARKER

Surveyed *April 13, 1960*, by *C. D. Bartsch*