


G-1369
28859

Twp 34S, R19E, WM

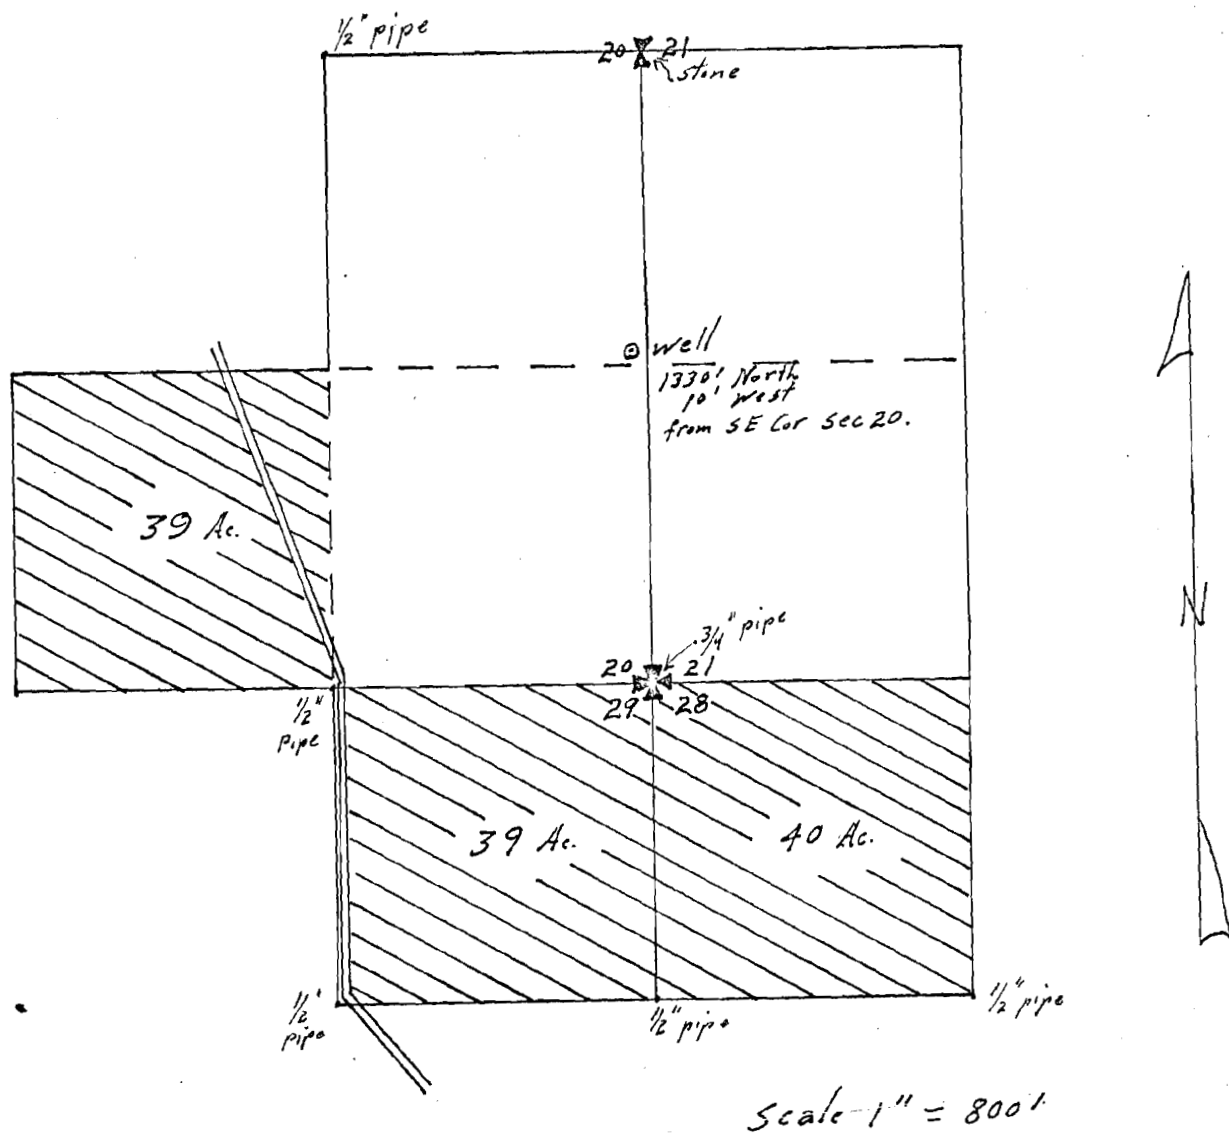

Application No. G-1491
Permit No. G-1369