


# T. 40S. R. 19E. W.M.

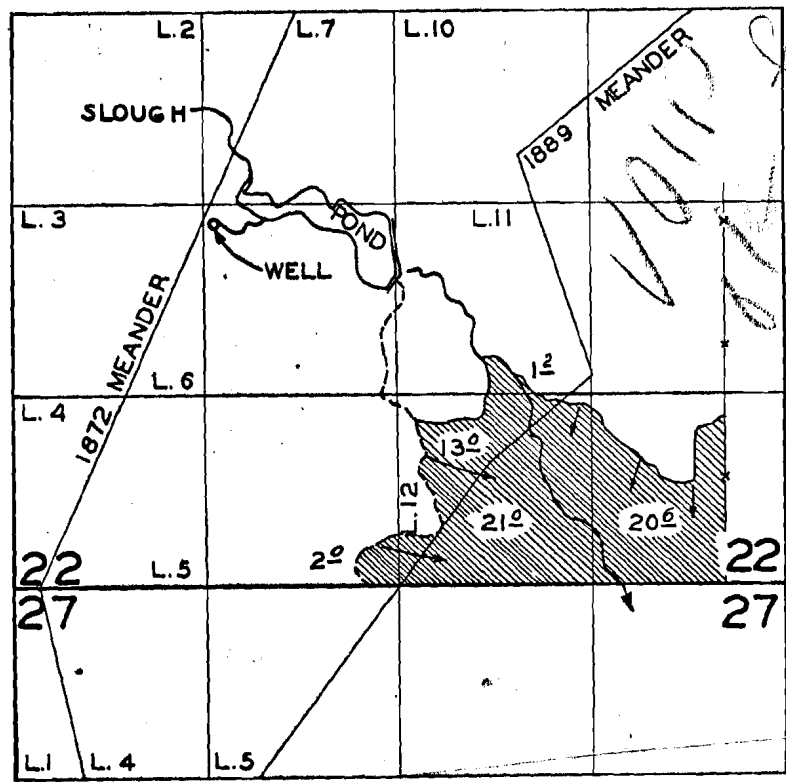

*VOID for area 1/4/19 insp. Appl map for well loc*

*Supplemental*

## FINAL PROOF SURVEY UNDER

Application No. G.12 Permit No. G.15.45  
IN NAME OF

RAYMOND E. FISHER

Surveyed NOV. 2 1960, by [Signature]