


T.16S.R.3W.W.M.

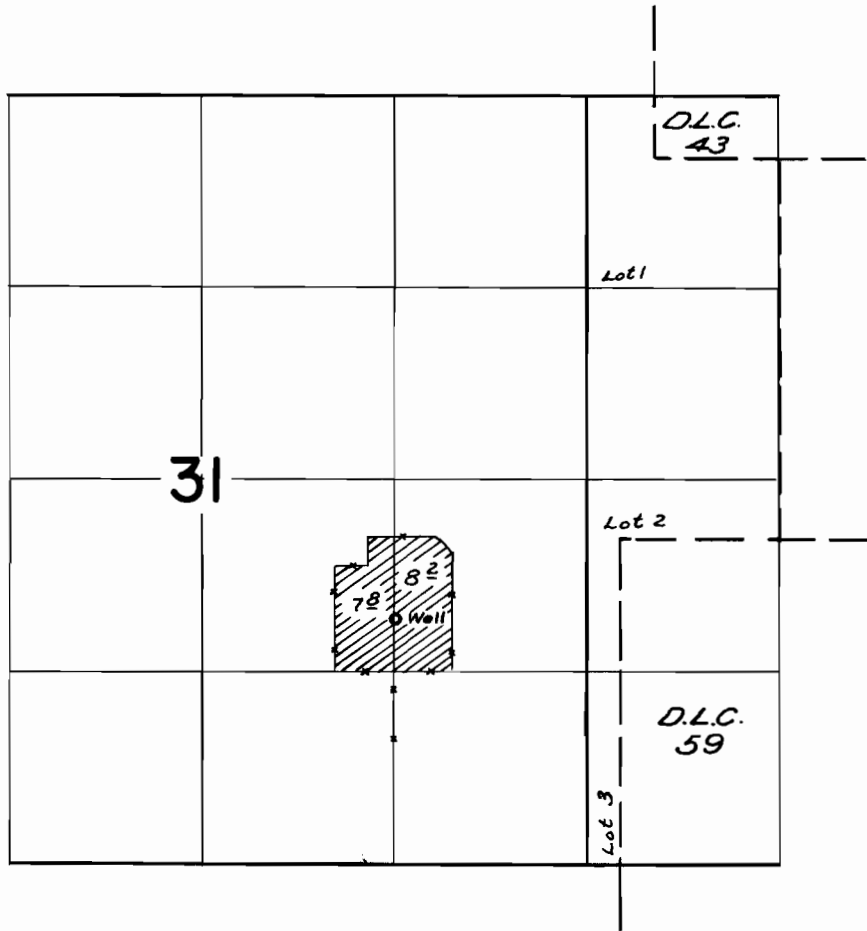

**FINAL PROOF SURVEY**  
UNDER

Application No. G-329 Permit No. G-219  
IN NAME OF

MARION L. SMITH

Surveyed 27 APRIL 1960, by M. B. [Signature]