


T.21S.R.3E.W.M.

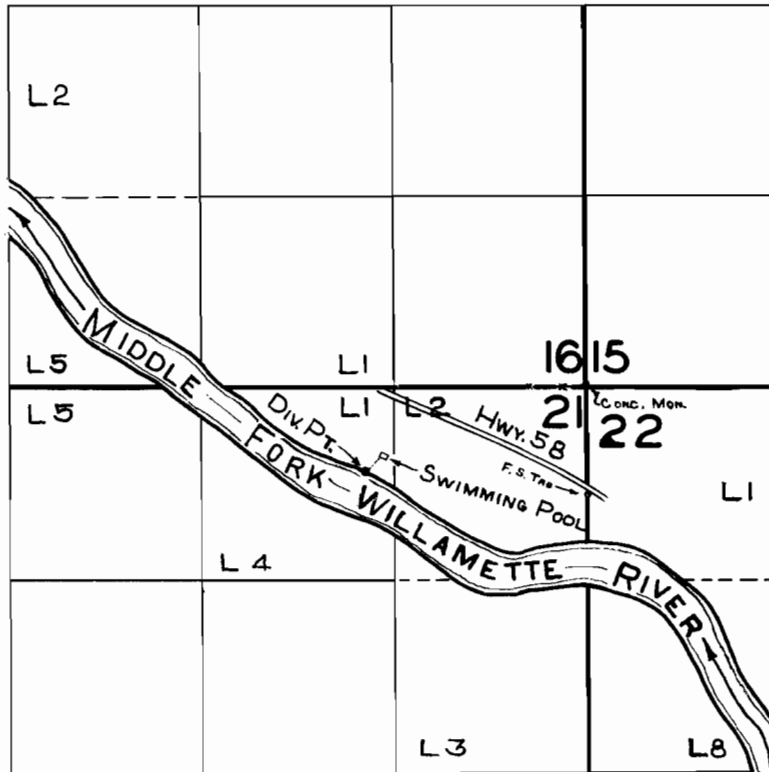

FINAL PROOF SURVEY UNDER

Application No. 30065... Permit No. 23417...
IN NAME OF

CITY OF OAKRIDGE

Surveyed SEPT. 1, 1960, by M. BISH