


T.17S.R.2W.W.M.

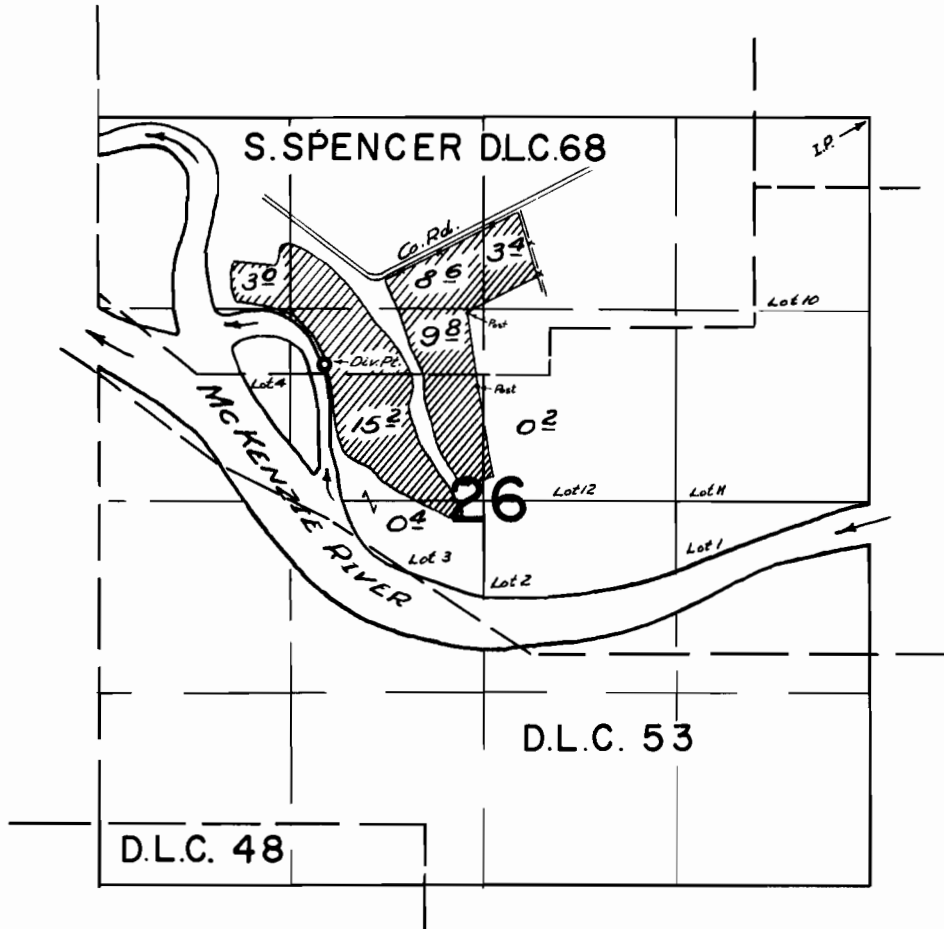

FINAL PROOF SURVEY UNDER

Application No. 30462 Permit No. 23994
IN NAME OF

J. E. HAMER

Surveyed 4 MAY 1960, by M. Bish