


T.16S.R4W.W.M.

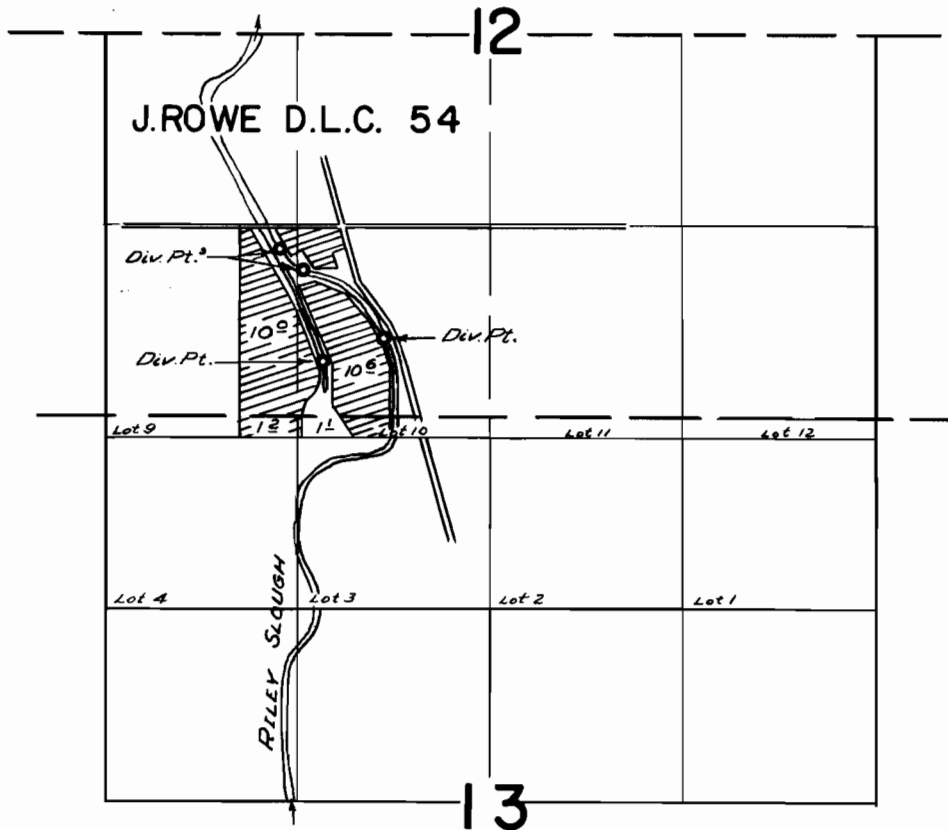

FINAL PROOF SURVEY
UNDER

Application No. 30583 Permit No. 24087
IN NAME OF

LAURA RIGGS

Surveyed 2 MAY 1960, by M. Bish