


T.17S.R.1W.W.M.

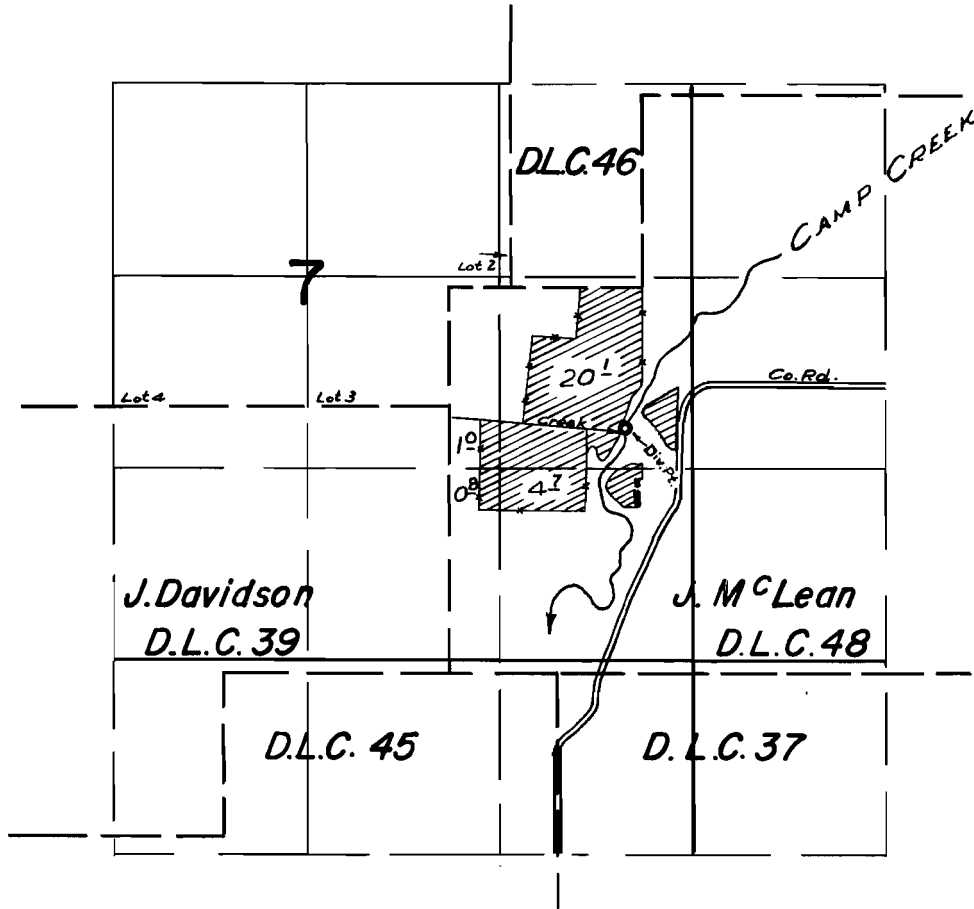

FINAL PROOF SURVEY UNDER

Application No. 30640 Permit No. 24139
IN NAME OF

HERMAN C. & CONSTANCE K. MITTEN

Surveyed 4 MAY 1960, by Joe Bish