


T. 17S. R. 2W. W.M.

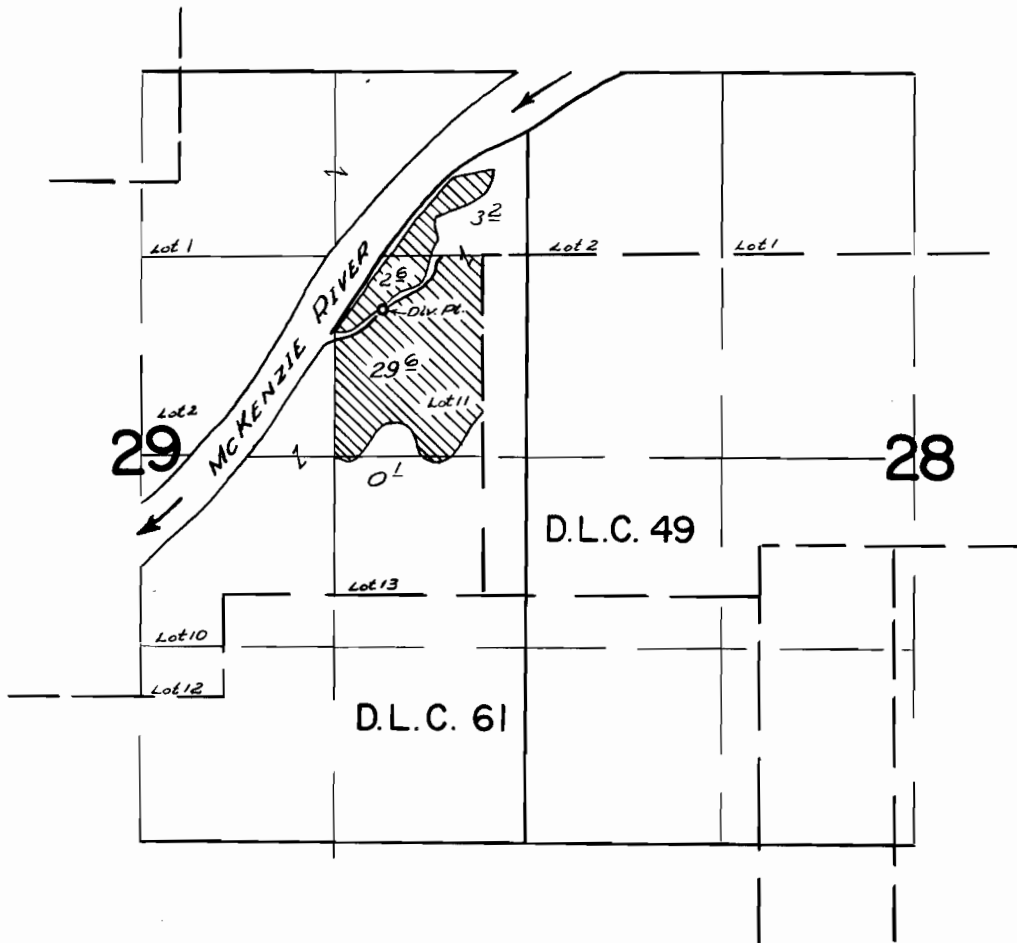

FINAL PROOF SURVEY
UNDER

Application No. 31022 Permit No. 24419
IN NAME OF

ARTHUR R. & HELEN N. QUACKENBUSH

Surveyed MAY 3 1960; by M. B. Bish