


THOMAS N. AUBRY D.L.C. No. 39



T. 17 S., R. 3 W., W.M.  
Section 7.

ALVIN B. STEVENS  
D.L.C. No. 40

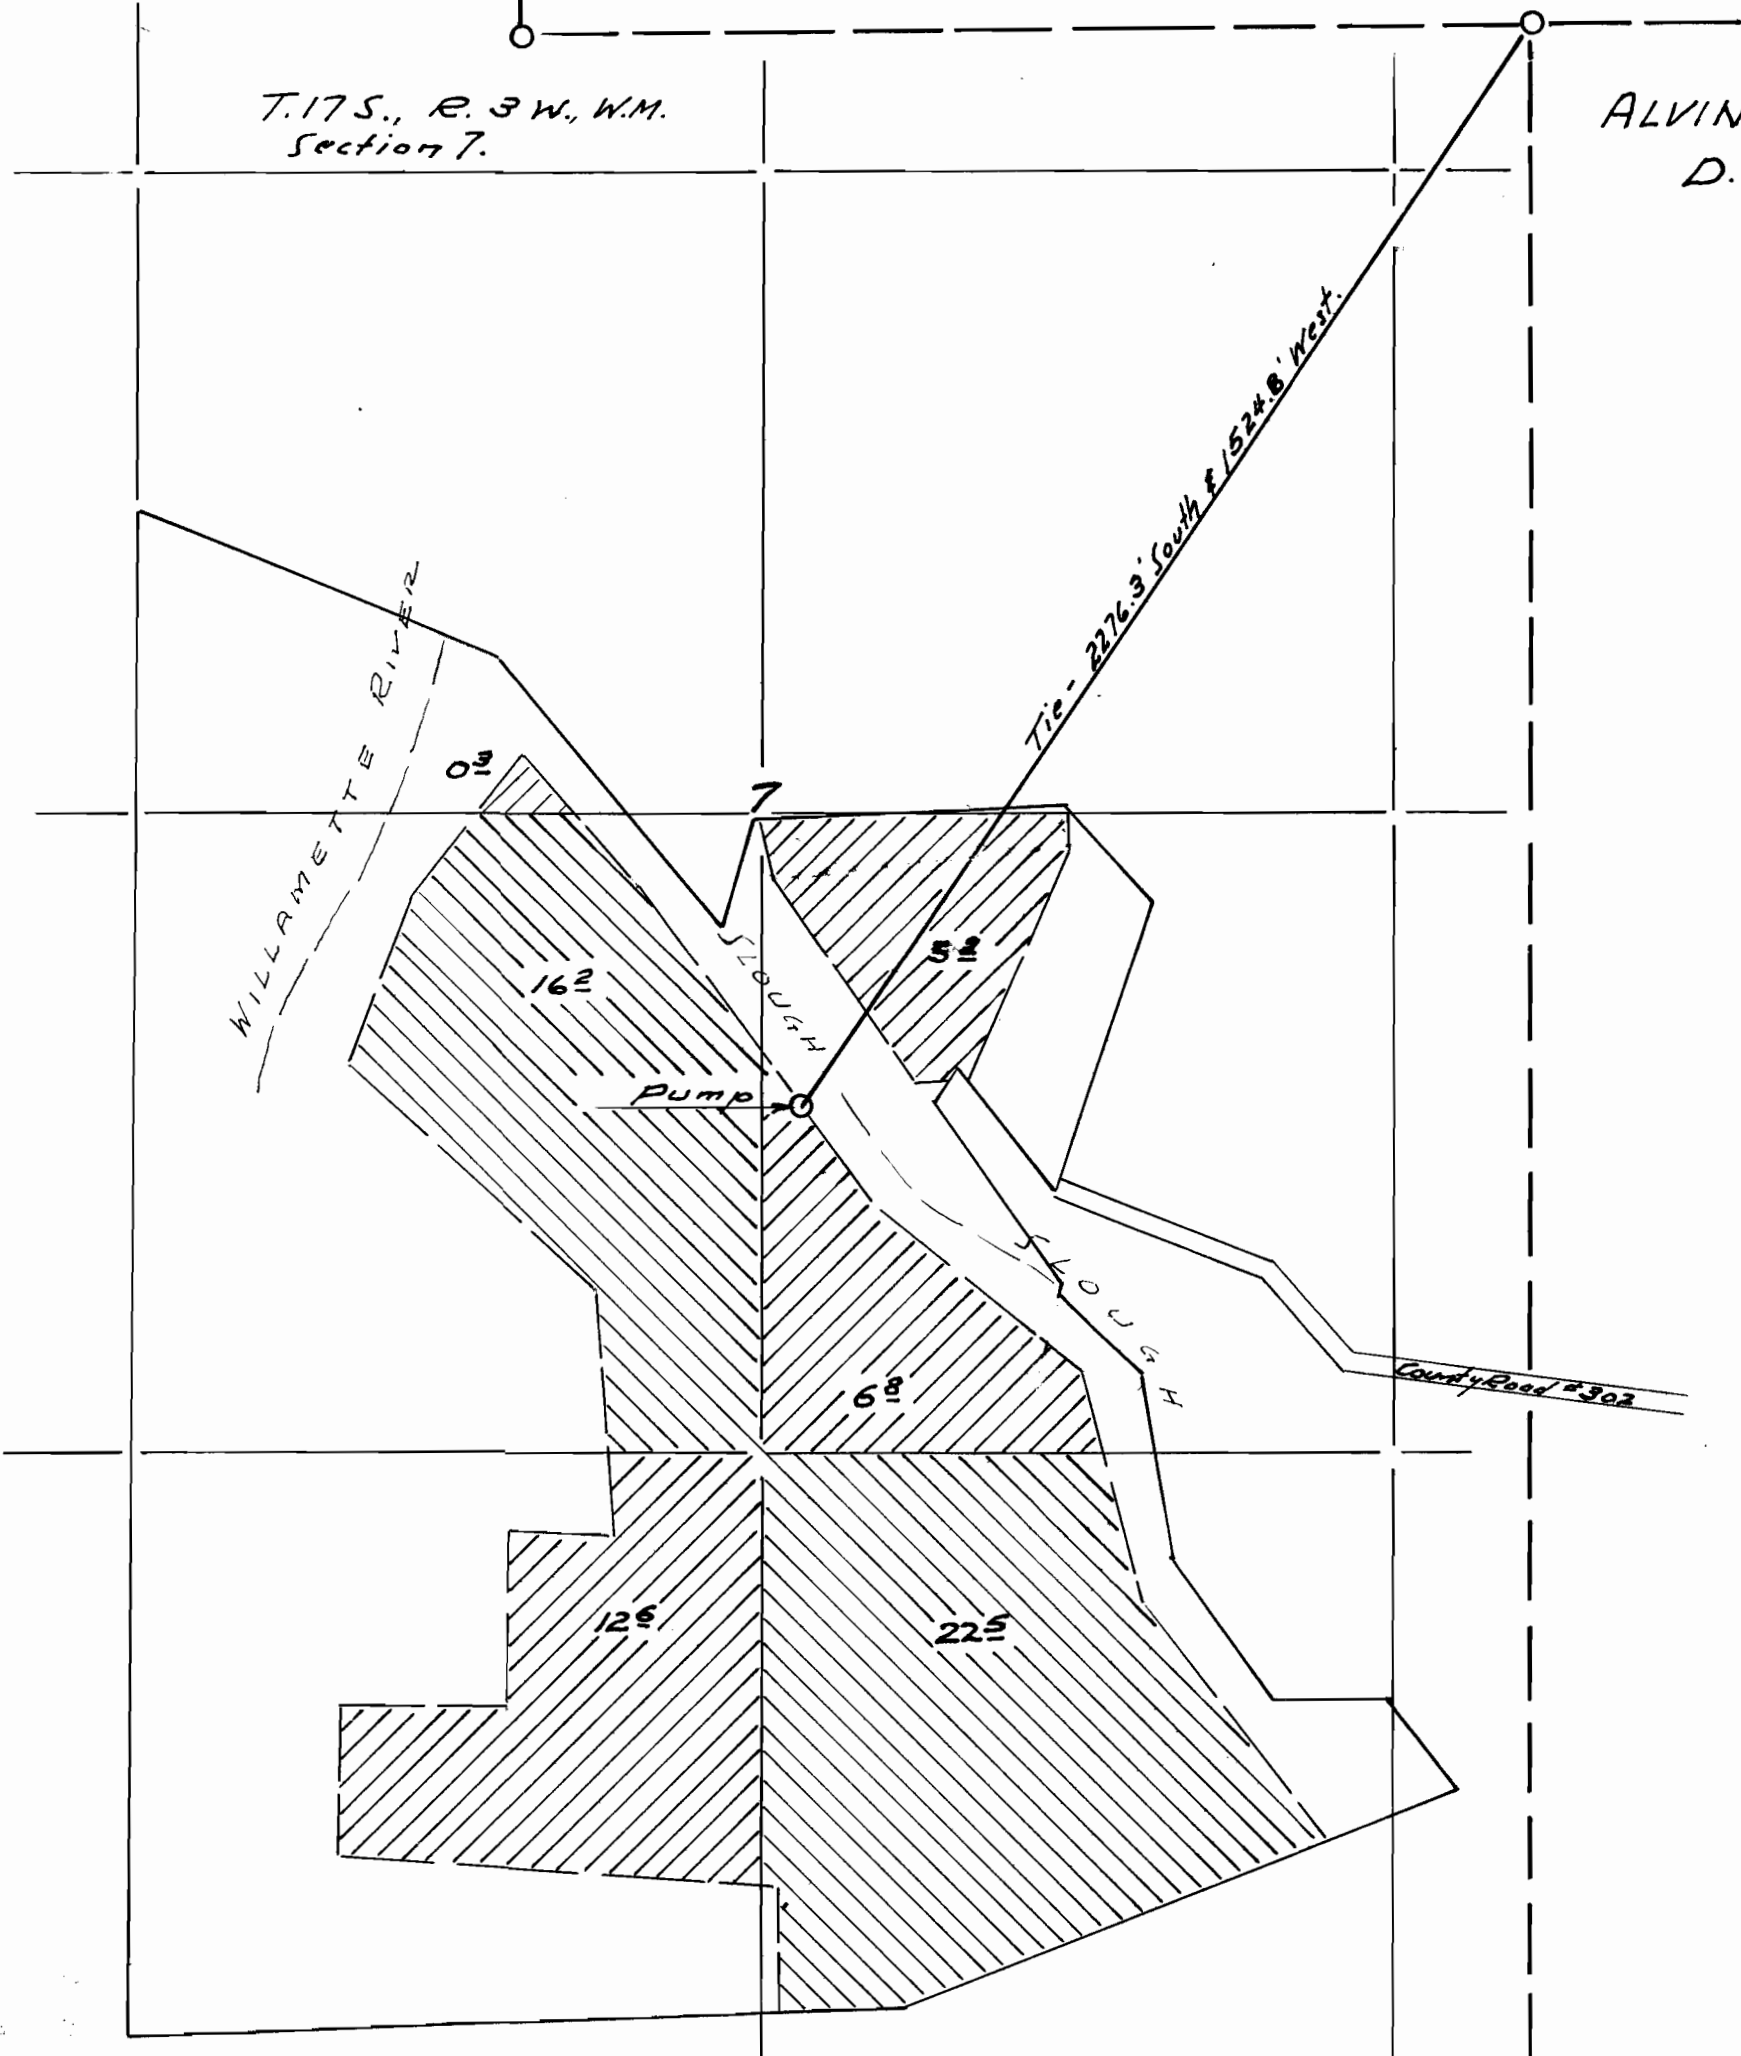

I, James C. Carleton, of 200 Cal Young Road, Eugene, Oregon do hereby certify that this map was made from notes taken during an actual survey made by me on April 16, 1957; that the monument shown on this map consisting of an 4" iron pipe is 2276.3' South and 1524.8' West of the N.W. Corner of the Alvin B. Stevens D.L.C. No. 40 in Sec. 7 T. 17 S. R. 3 W. W.M. in Lane County, Oregon.

*James C. Carleton*

APPLICATION FOR WATER RIGHT  
For

WILLIAM A. & NAOMI AYRES  
675 Ayres Road, Eugene, Oregon

Scale 1"=400'

April 17, 1957

J. C. Carleton, 200 Cal Young Road, Eugene, Ore.

Application No. 31522  
Permit No. 24961