


# T.17S.R.2W.W.M.

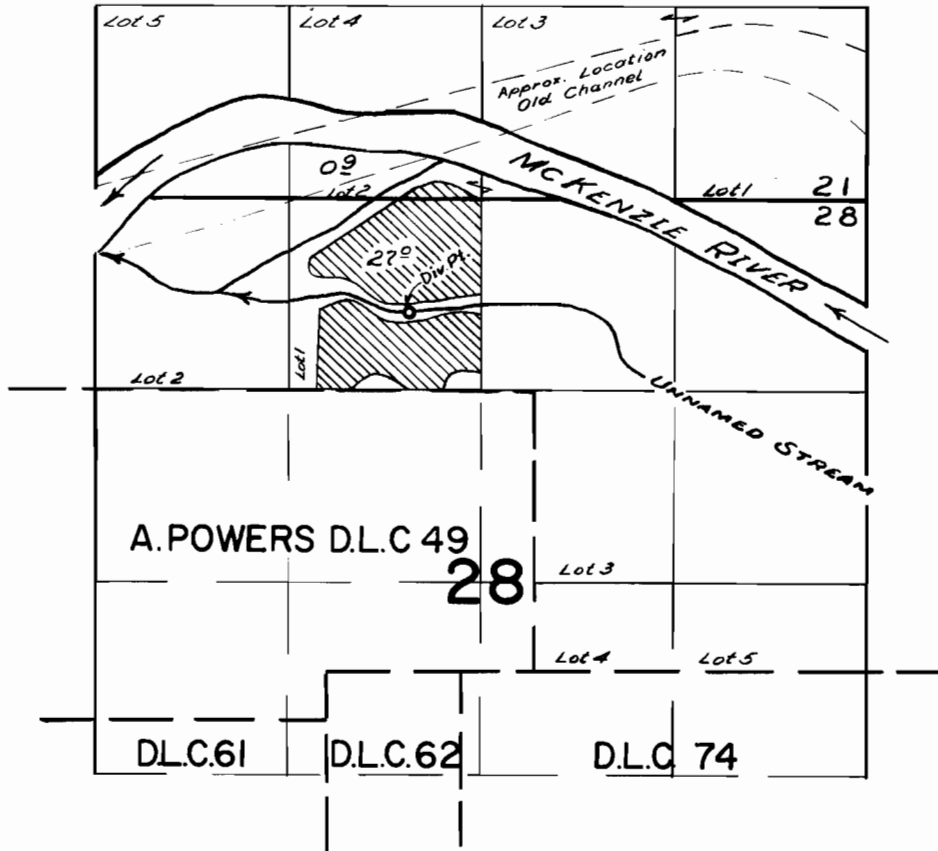

## FINAL PROOF SURVEY UNDER

Application No. 31750..... Permit No. 25084....  
IN NAME OF

.. ARTHUR R. QUACKENBUSH ..

Surveyed 3 MAY 1960, by M. Bishop.....