


T.18S.R.3W.W.M.

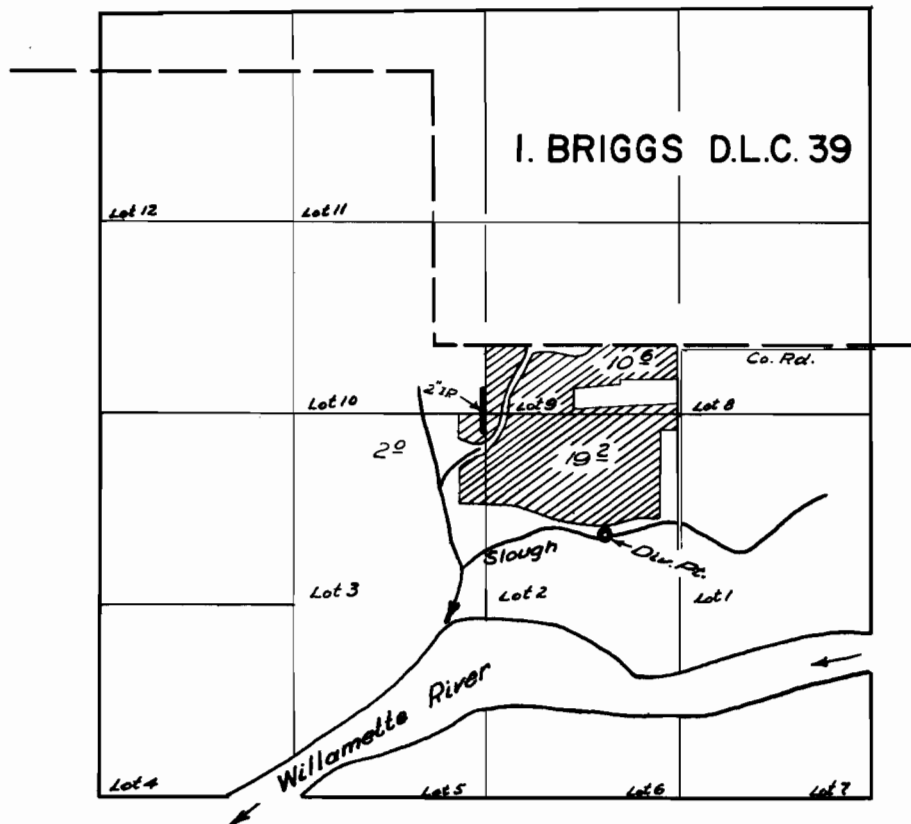

FINAL PROOF SURVEY
UNDER

Application No. 32075... Permit No. 25306...
IN NAME OF

LEWIS B. McBEE

Surveyed 2 May... 1960, by Tom Bish