


T16S.R.4 W.W.M.

*VOID
V.K. 1/11/60
T.D.*

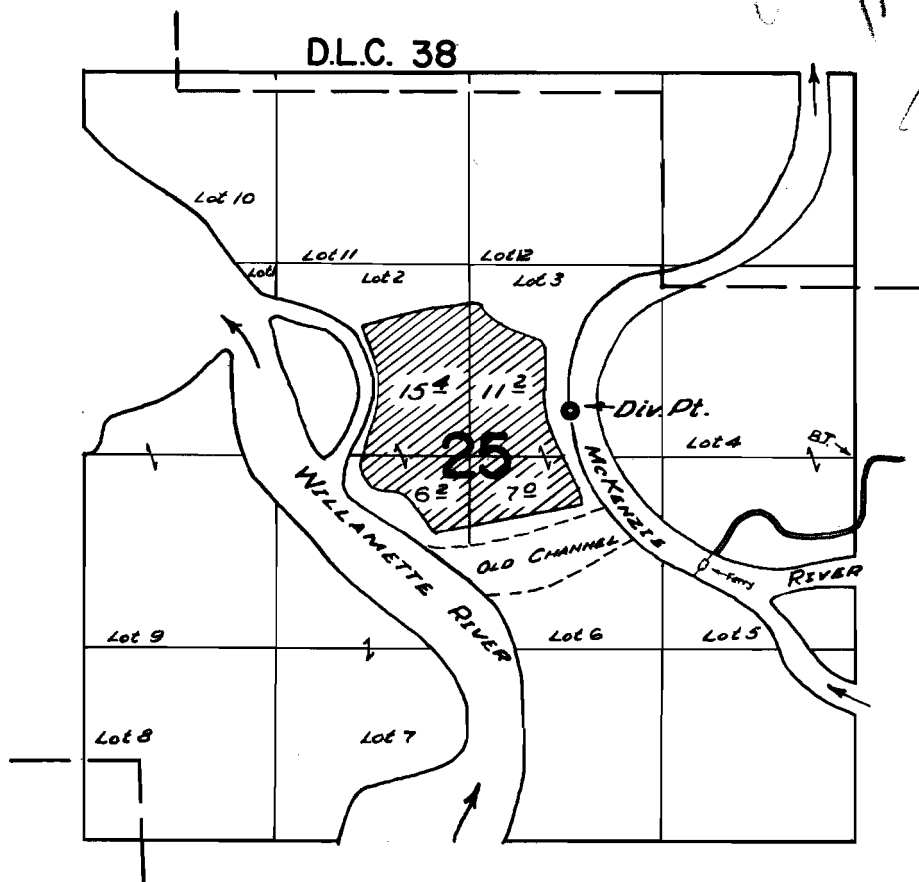

**FINAL PROOF SURVEY
UNDER**

Application No. 32110 Permit No. 25335
IN NAME OF

GREEN BROTHERS

Surveyed 2 MAY 1960, by M. Bish