


T. 18S. R. 2W. W.M.

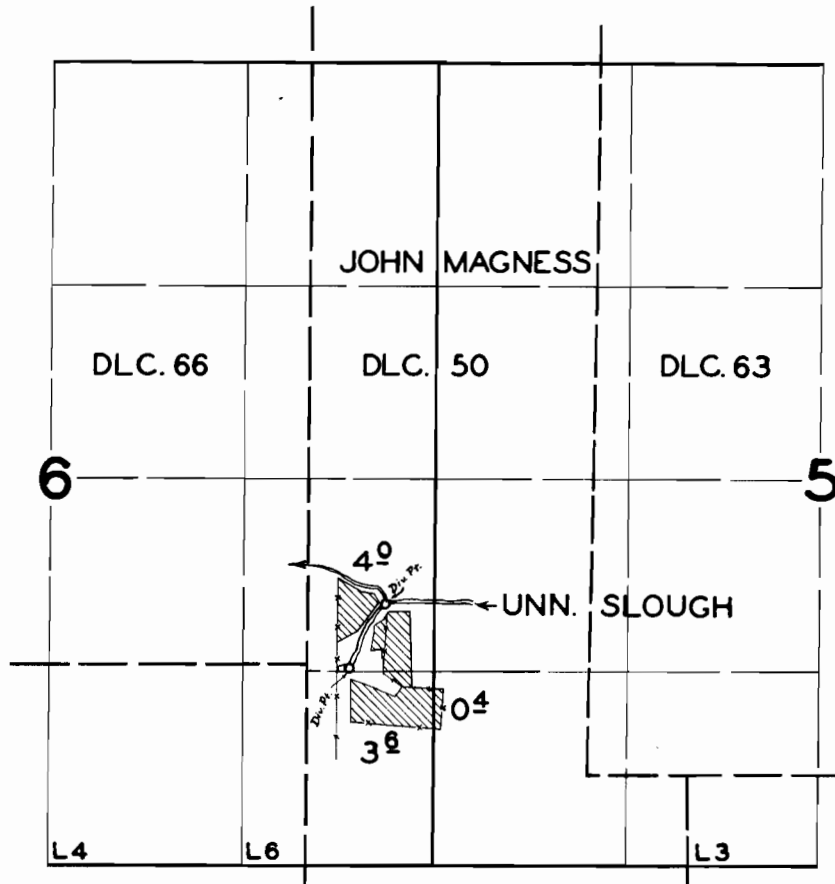

FINAL PROOF SURVEY
UNDER

Application No. 32185 Permit No. 25389
IN NAME OF

Lew A. & Metta Nell Williams

Surveyed MAR.23 1959, by M. BISH