


# T.17S.R.3W.W.M.

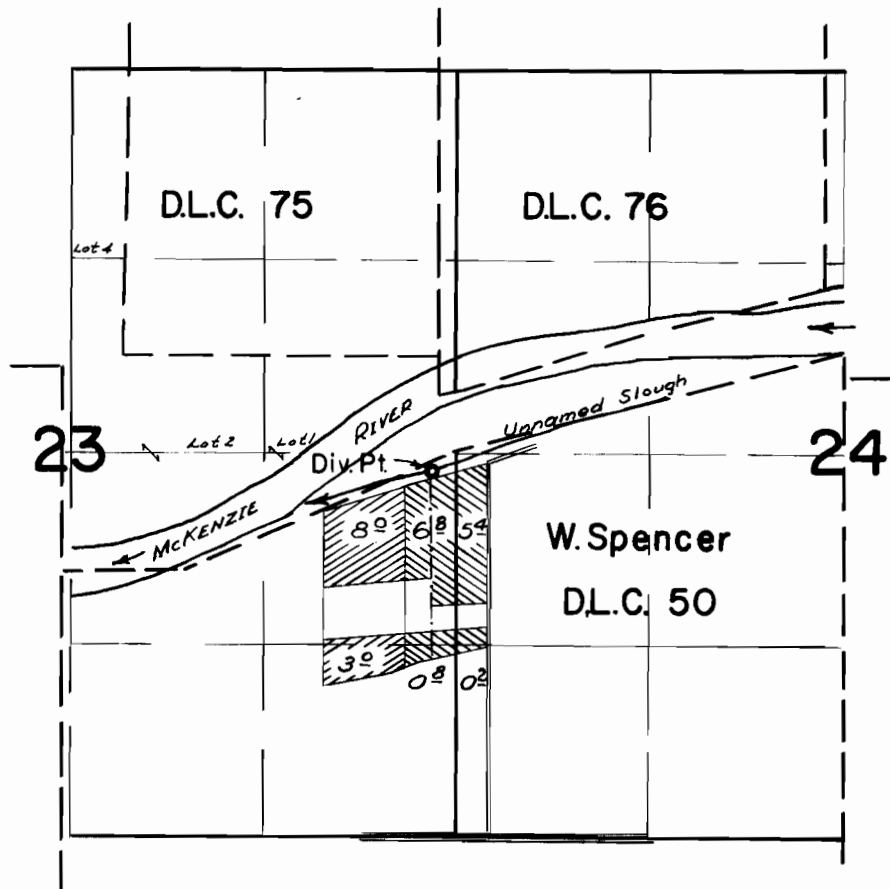

## FINAL PROOF SURVEY UNDER

Application No. 32256 Permit No. 25445  
 Application No. 32257 Permit No. 25446

IN NAME OF  
**AUGUST J. RODAKOWSKI**  
**MIKE J. RODAKOWSKI**

Surveyed 29 April 1960, by *M. Bish*