


T. 13S. R. 11W. W.M.

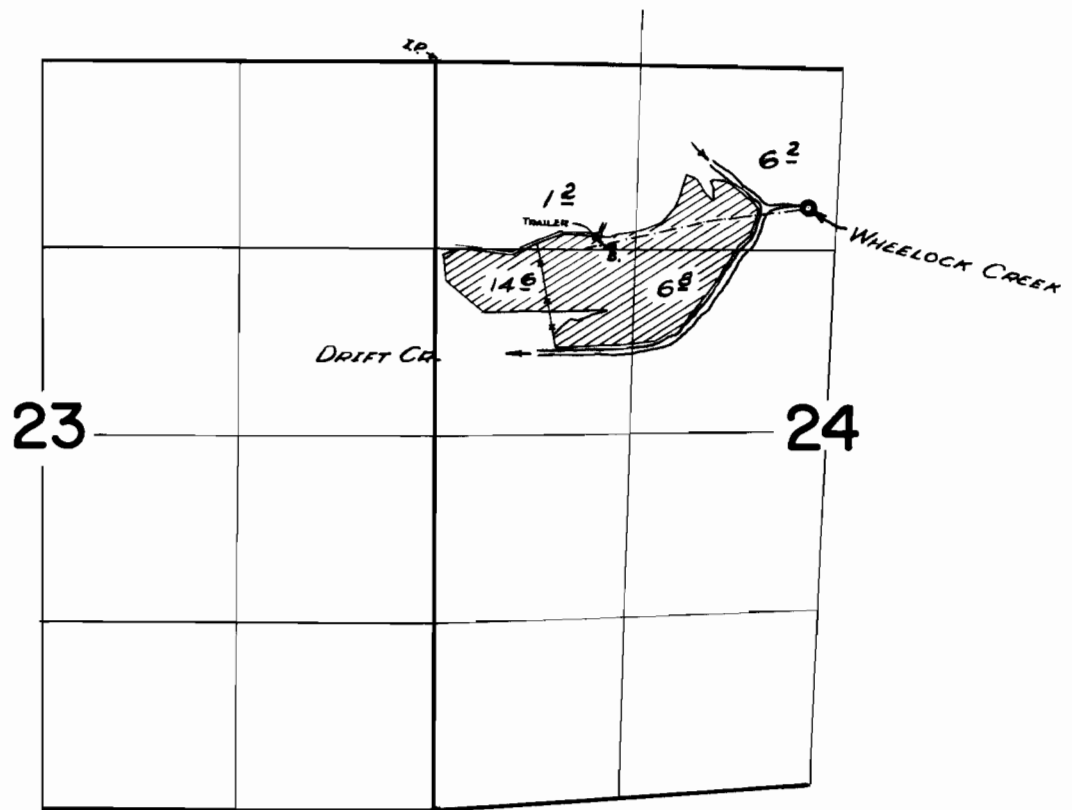

FINAL PROOF SURVEY
UNDER

Application No. 28000 Permit No. 22036
IN NAME OF

ROBERT B. MAY

15 JUNE
Surveyed 8 APRIL 1960, by R.H. WHITBY
Tr. B. B. B.

1957-M
1959-B