


# T.8S.R.10W.W.M.

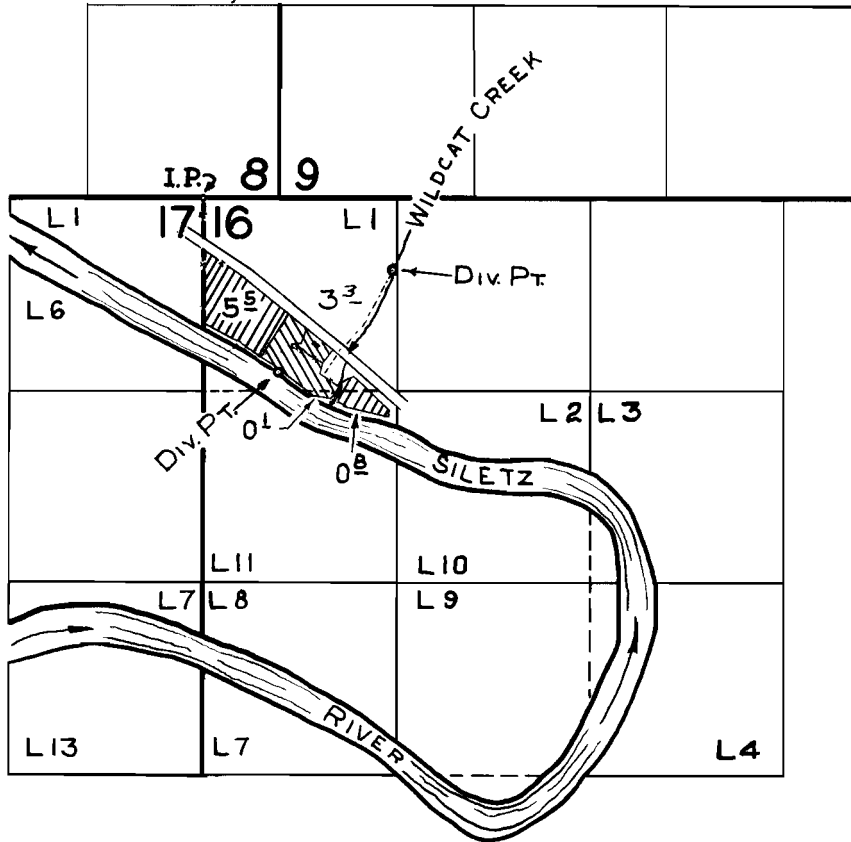

WILDCAT CR.
  SILETZ R.

## FINAL PROOF SURVEY UNDER

Application No. 30893 Permit No. 24283  
IN NAME OF

TIM H. BULLAND

Surveyed Aug. 12, 1960, by M. BISH