


Pacific Ocean

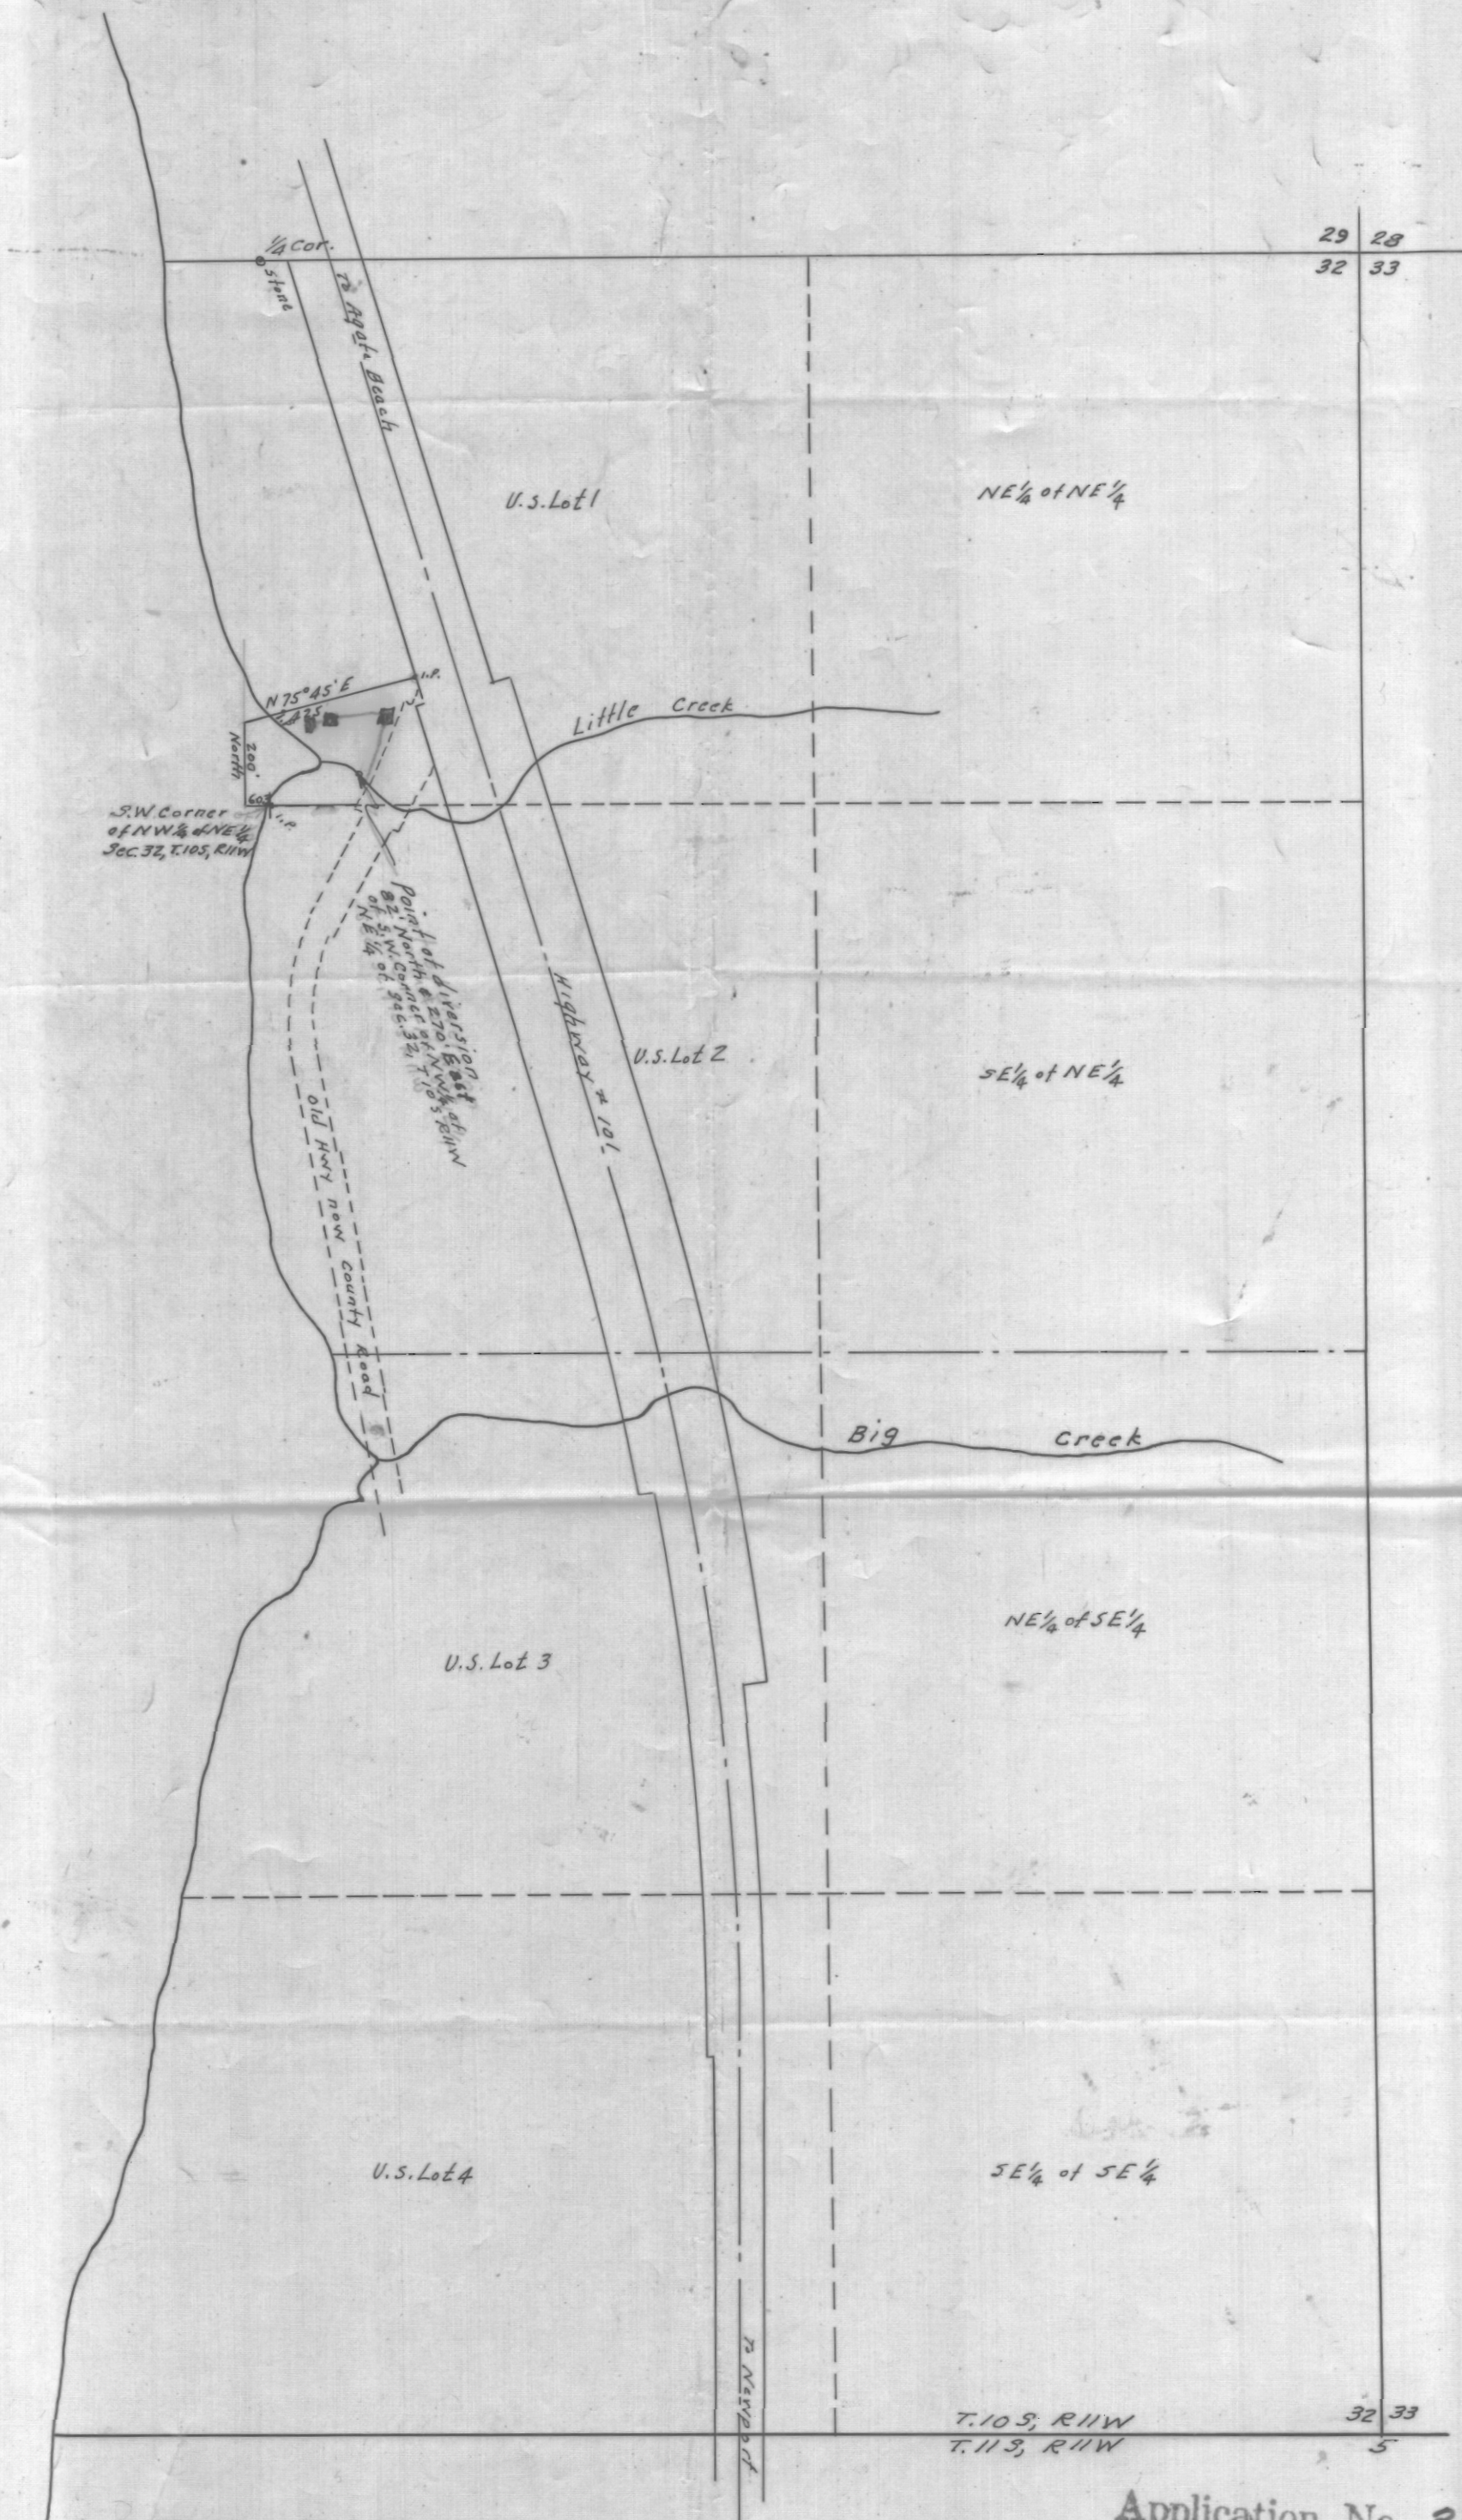

Application No. 33882
Permit No. 26703

Map For Water Right on Little Creek
In Section 32, T.10S, R.11W, W.M.
Application by Medwyn Watson
Scale: 1" = 400' Date: Apr. 14, 1960.

RECEIVED
APR 18 1960
STATE ENGINEER
SALEM, OREGON

REGISTERED
OREGON
LAND SURVEYOR

W. H. Burdett
NOV. 16 1944
W. H. BURDETT
45

RECEIVED
MAY 2 - 1960
STATE ENGINEER
SALEM, OREGON