


T.1S.R.2W.W.M.

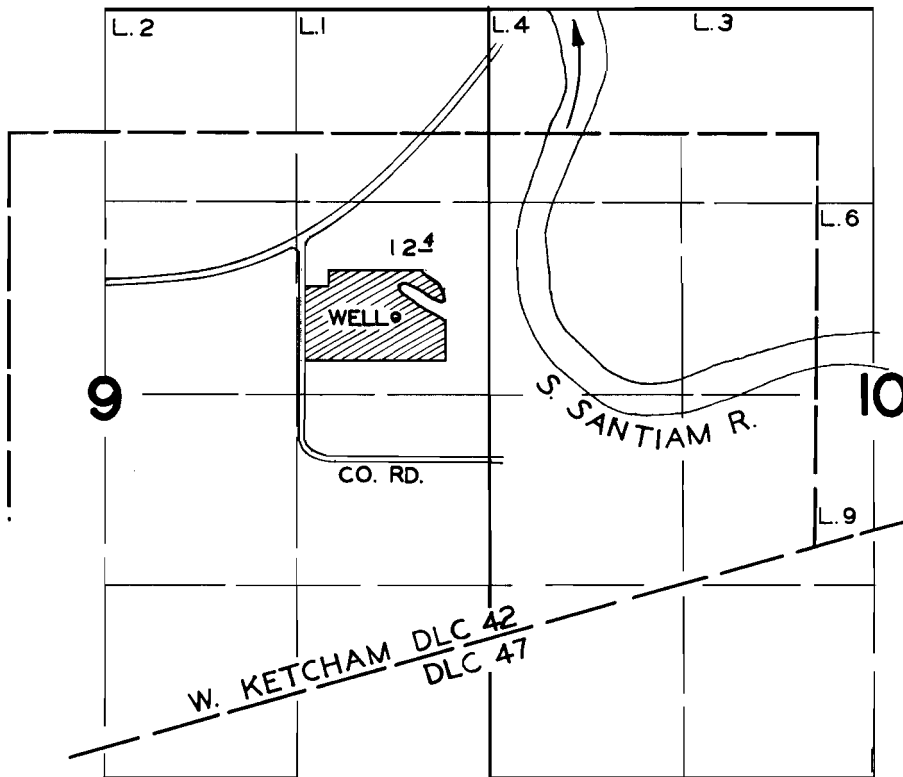

FINAL PROOF SURVEY UNDER

Application No. G327..... Permit No. G217.....
IN NAME OF

ROY J. BLENZ

Surveyed OCT. 12, 1960, by R.H. JACKSON