


T.11S. R.3W.W.M.

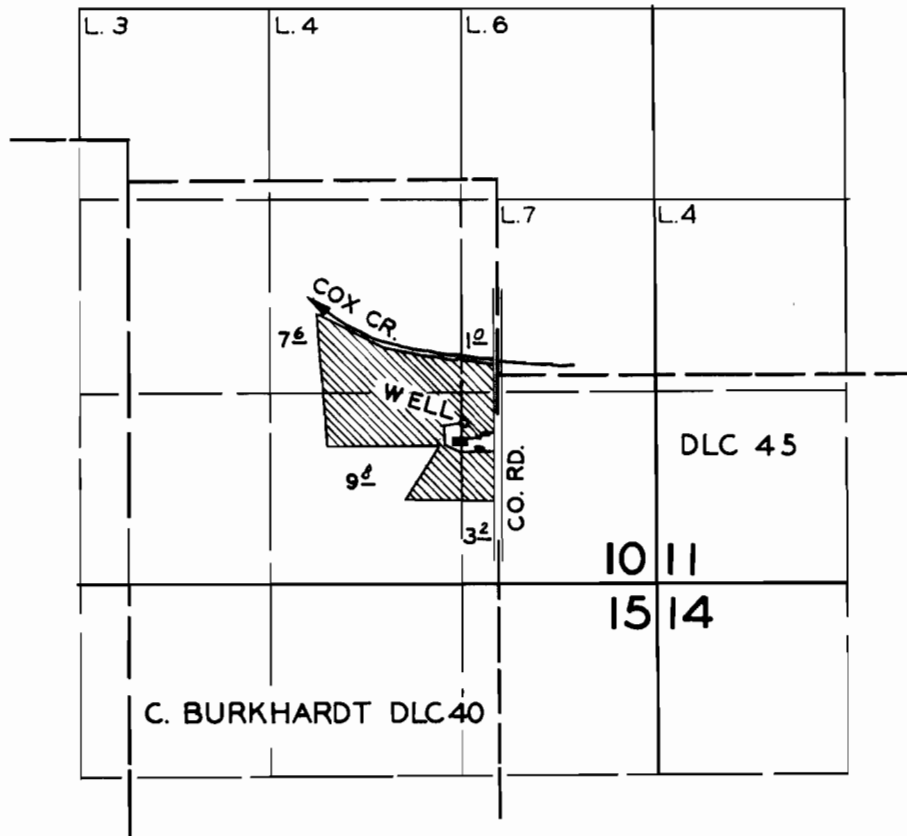

FINAL PROOF SURVEY UNDER

Application No. G.574 Permit No. G.493
IN NAME OF

LEO A. & ESTHER M. KROFF

Surveyed OCT. 13 1960, by R. H. JACKSON