


T.I.S.R.I.W.W.M.

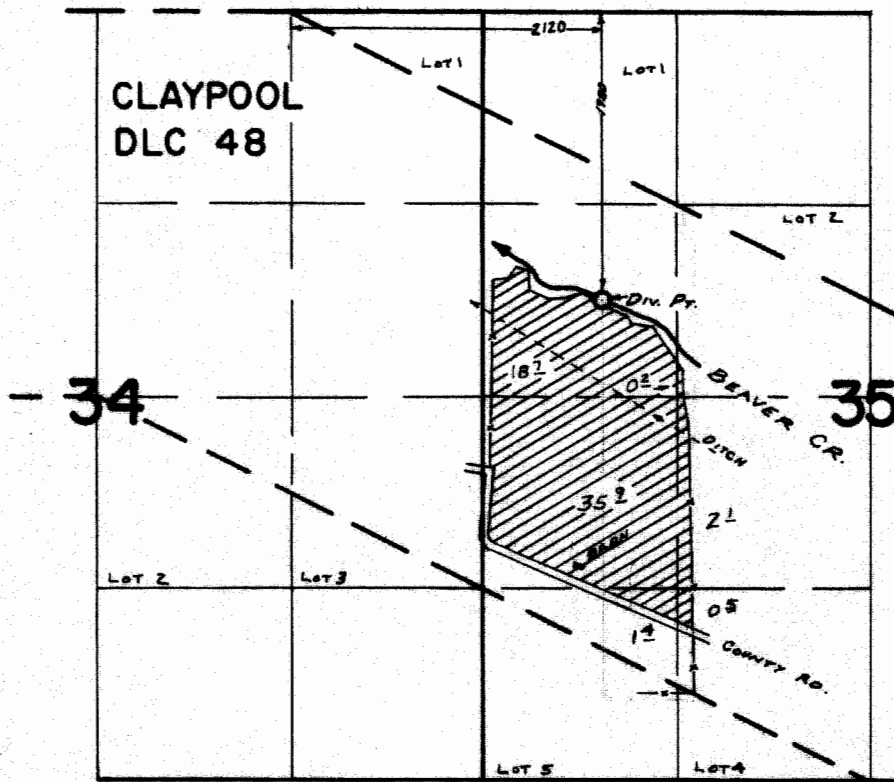

FINAL PROOF SURVEY UNDER

Application No. 12087..... Permit No. 31496.....
IN NAME OF

NORMAN A. & EDITH MYRICK

Surveyed JULY 2, 1969, by W. RUPPERT