W.R. 697
D. ROYCE LANG
Sec. 31, T.13 S., R.1 E., W.M.
Linn County, Ore.
Scale: 1"-200' June 16, 1959

Application No. 33165
Permit No. 26232

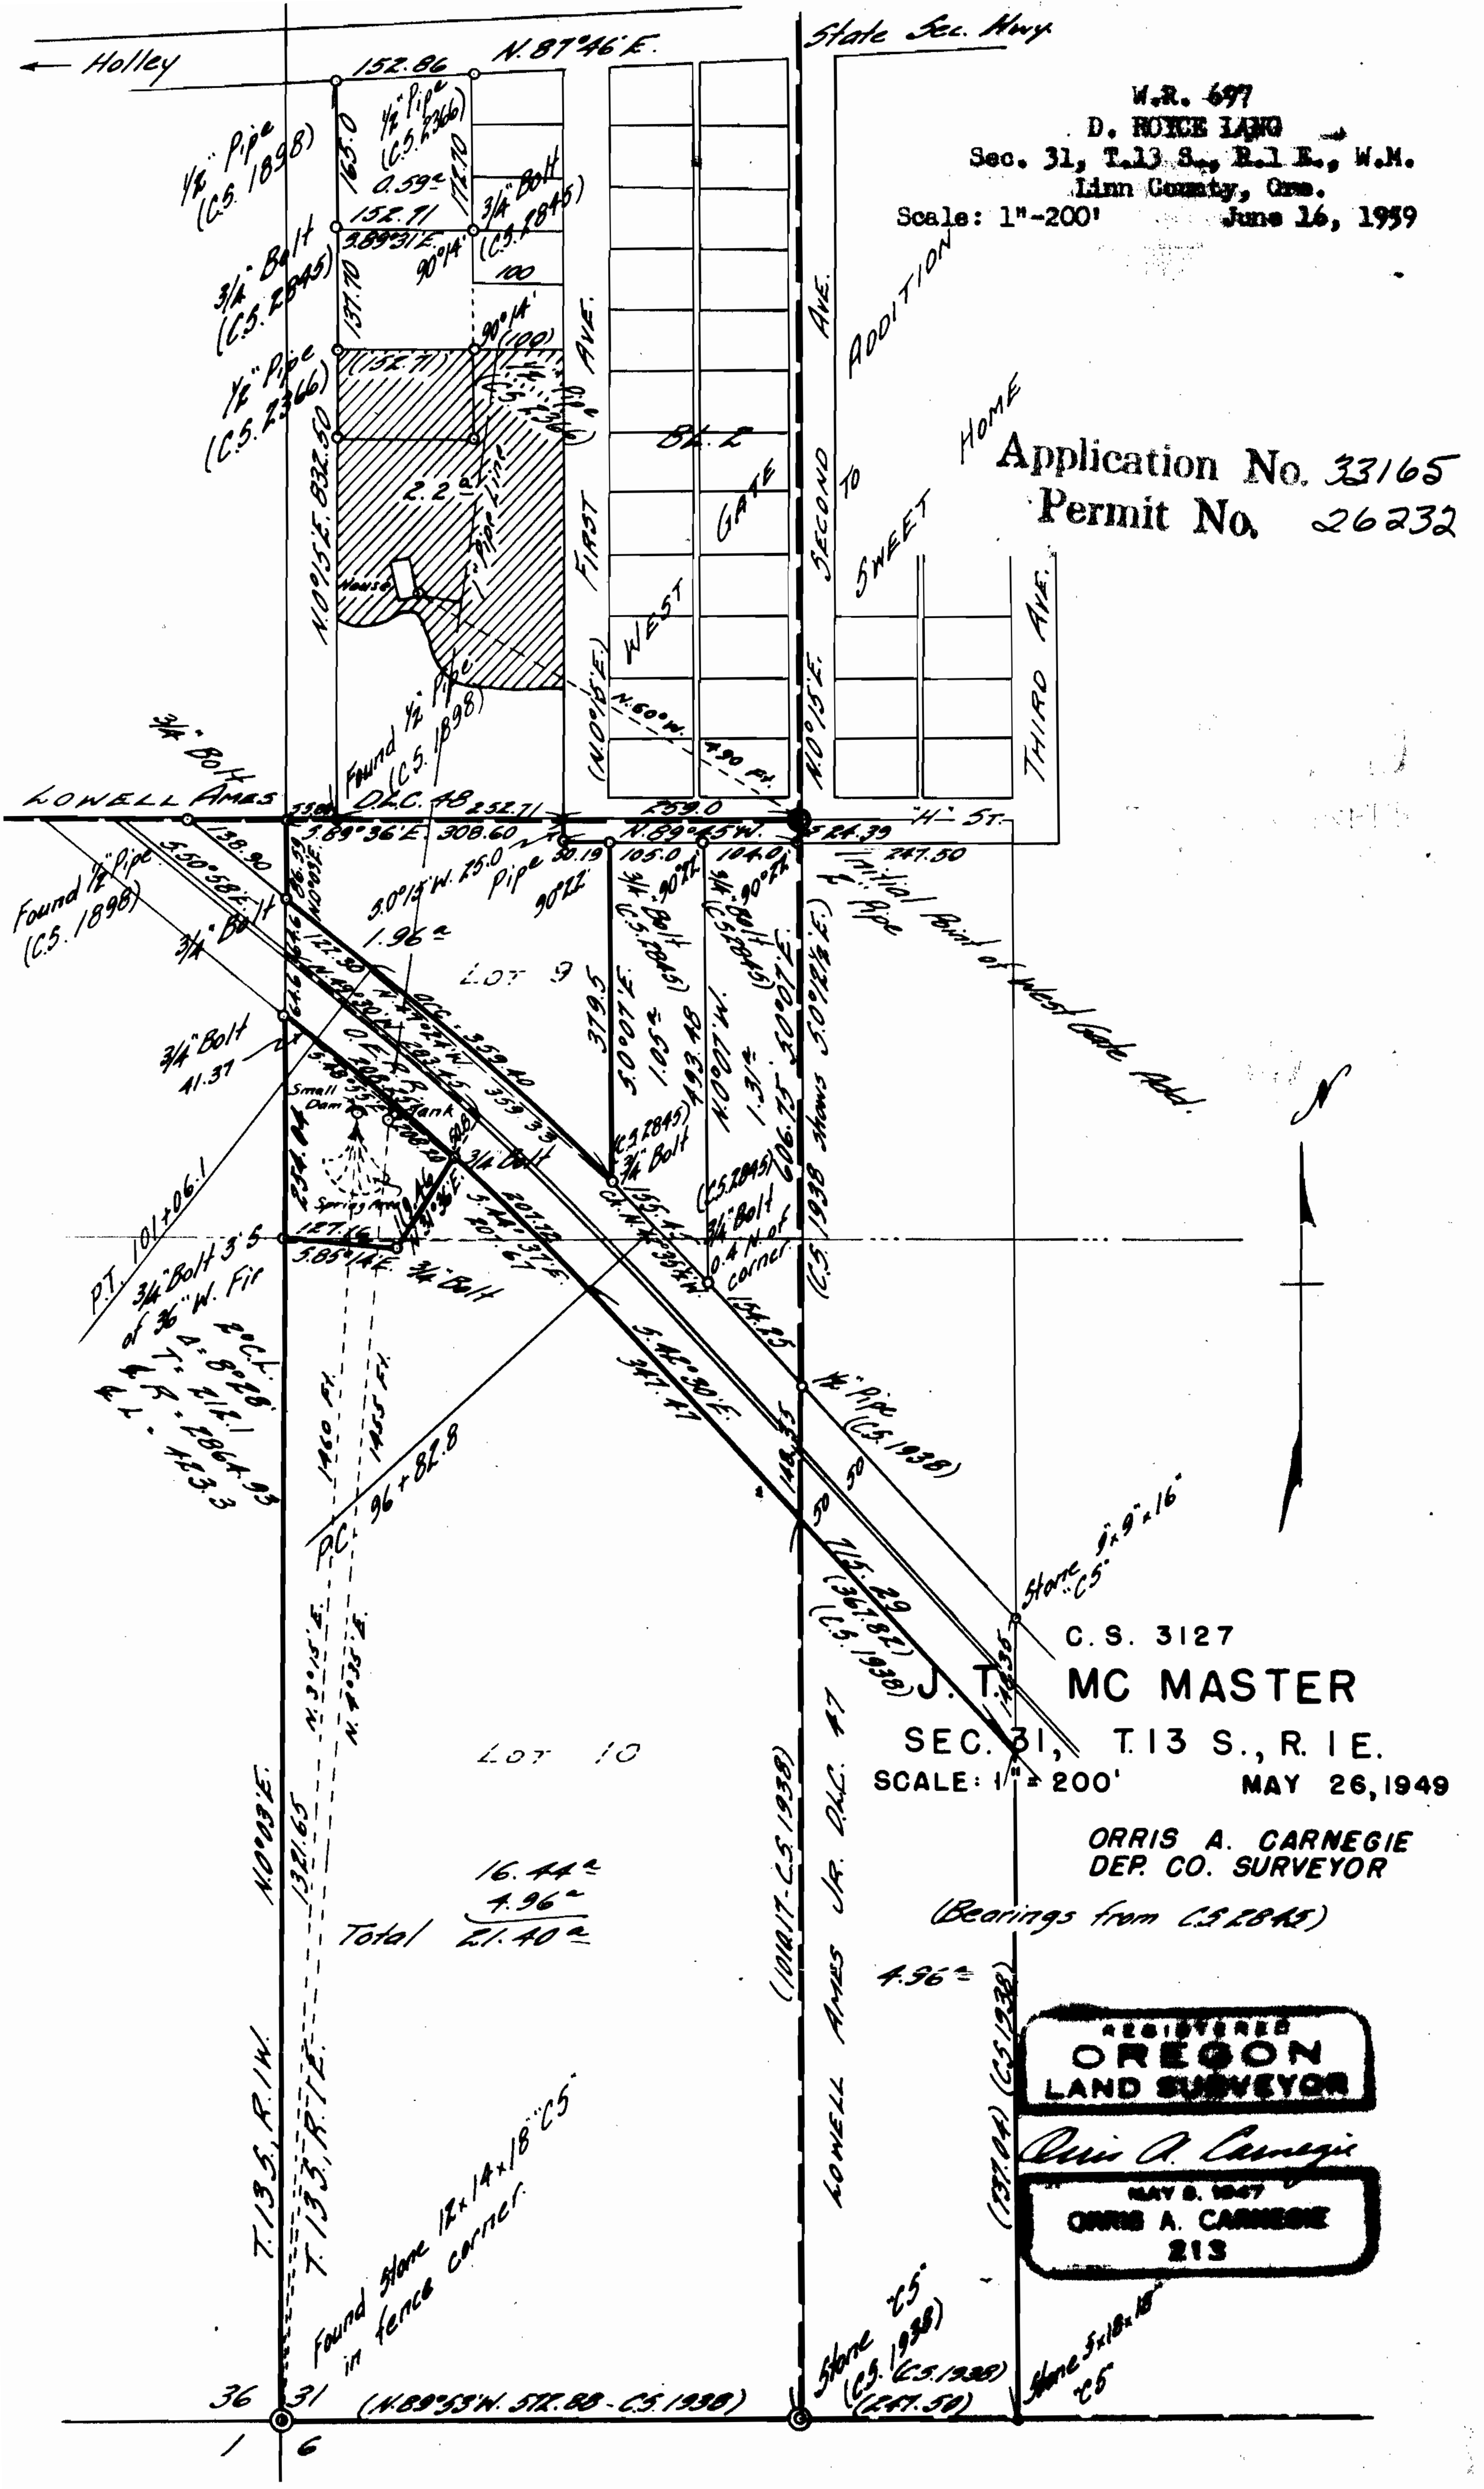

C.S. 3127

J. T. MC MASTER
SEC. 31, T. 13 S., R. 1 E.
SCALE: 1" = 200' MAY 26, 1949

ORRIS A. CARNEGIE
DEP. CO. SURVEYOR

(Bearings from C.S. 2845)

REGISTERED
OREGON
LAND SURVEYOR

Orris A. Carnegie

MAY 8, 1947
ORRIS A. CARNEGIE
213