


T.19S. R.42 E.W.M.

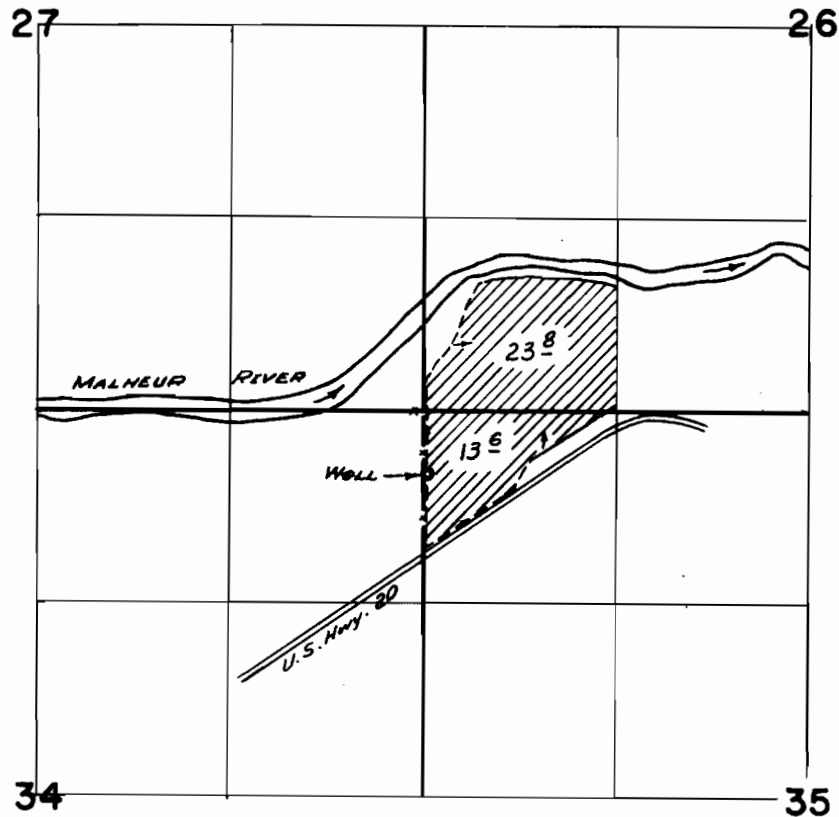

FINAL PROOF SURVEY
UNDER

Application No. G-450 Permit No. G-343
IN NAME OF

JOHN E. O'TOOLE

Surveyed 18 JULY 1960, by Mr. B. J. ...