


T.20S.R.47E.W.M.

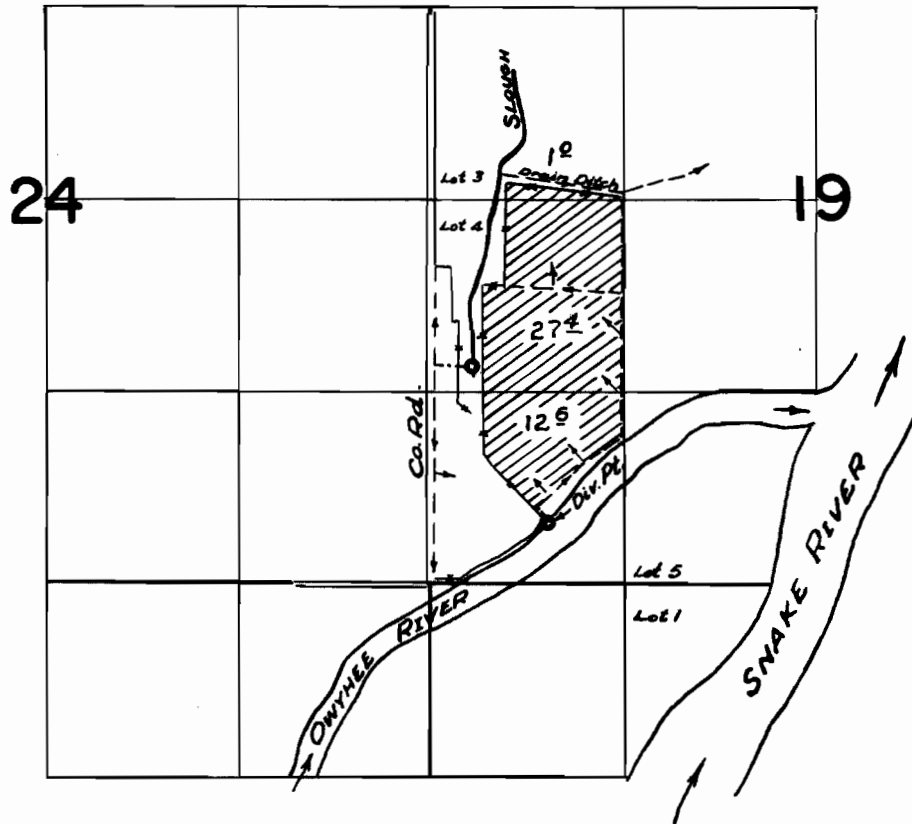

**FINAL PROOF SURVEY**  
UNDER

Application No. 28942 Permit No. 22767....  
IN NAME OF

WALTER S. WISMER

Surveyed 3 Nov.... 1960, by Mr. Bish.....