


T.15 S.R.46 E.W.M.

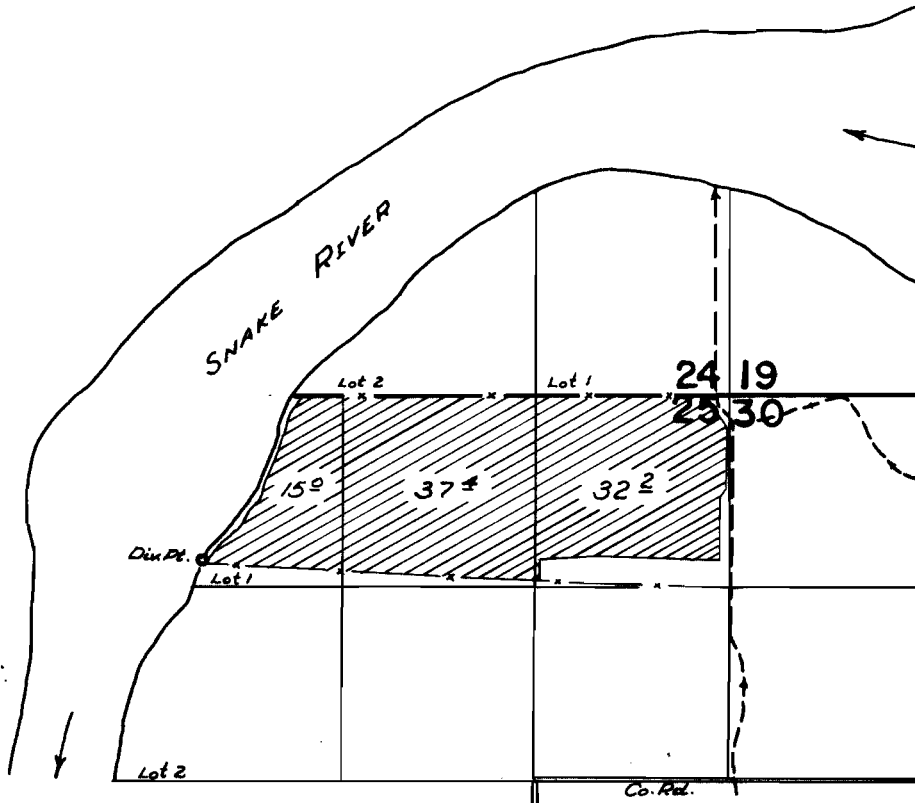

**FINAL PROOF SURVEY**  
UNDER

Application No. 30702 Permit No. 24188  
IN NAME OF

A.E. GIBBS

Surveyed 28 Oct. 1960, by M. B. Bish