


T.3&4S. R.2W.W.M.

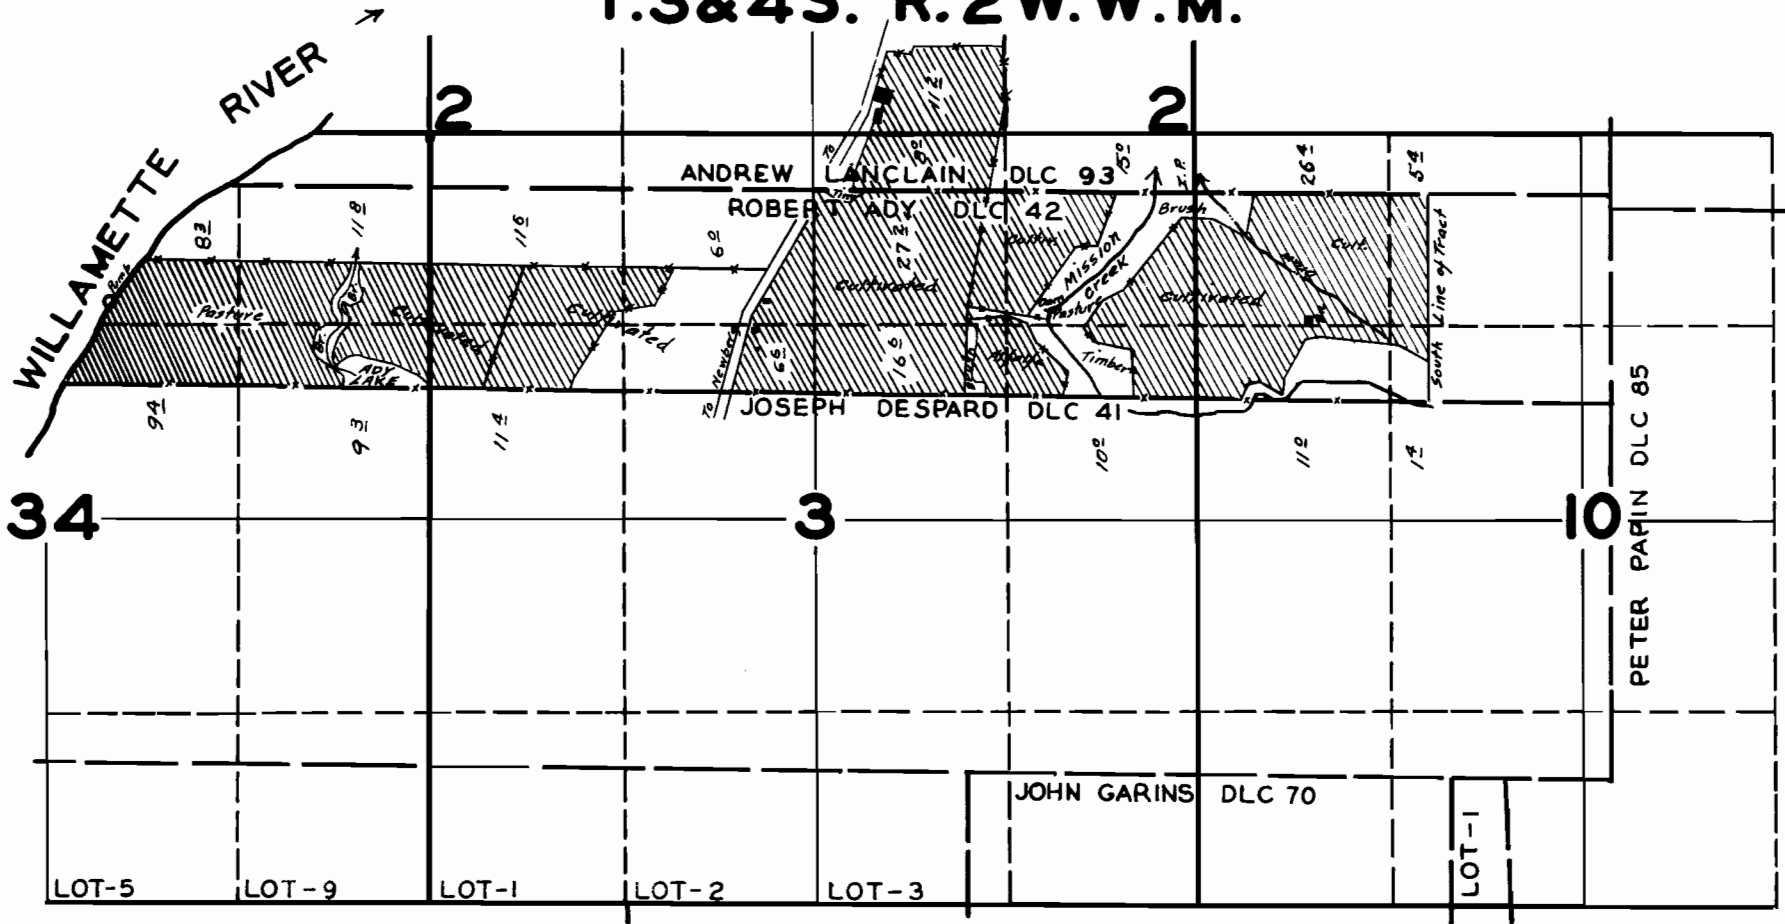

FINAL PROOF SURVEY
UNDER

Application No. 18000 Permit No. 13672

IN NAME OF

C. & W. SMITH

Surveyed JUNE 191944, by *J. A. Russell*

