




I, *G. R. Boatwright* OF SALEM, OREGON DO HEREBY
 CERTIFY THAT THIS MAP WAS MADE FROM NOTES
 TAKEN DURING AN ACTUAL SURVEY MADE UNDER
 MY IMMEDIATE SUPERVISION ON SEP. 10, 1956;
 THAT THE MONUMENT SHOWN ON THIS MAP CONSISTING
 OF AN 8" WELL CASING IS NORTH 1318.47' AND
 N89°36'E 643.81' FROM S.E. CORNER SAMUEL WALKER
 D.L.C. # 39

Application No. G-482
 Permit No. G-374

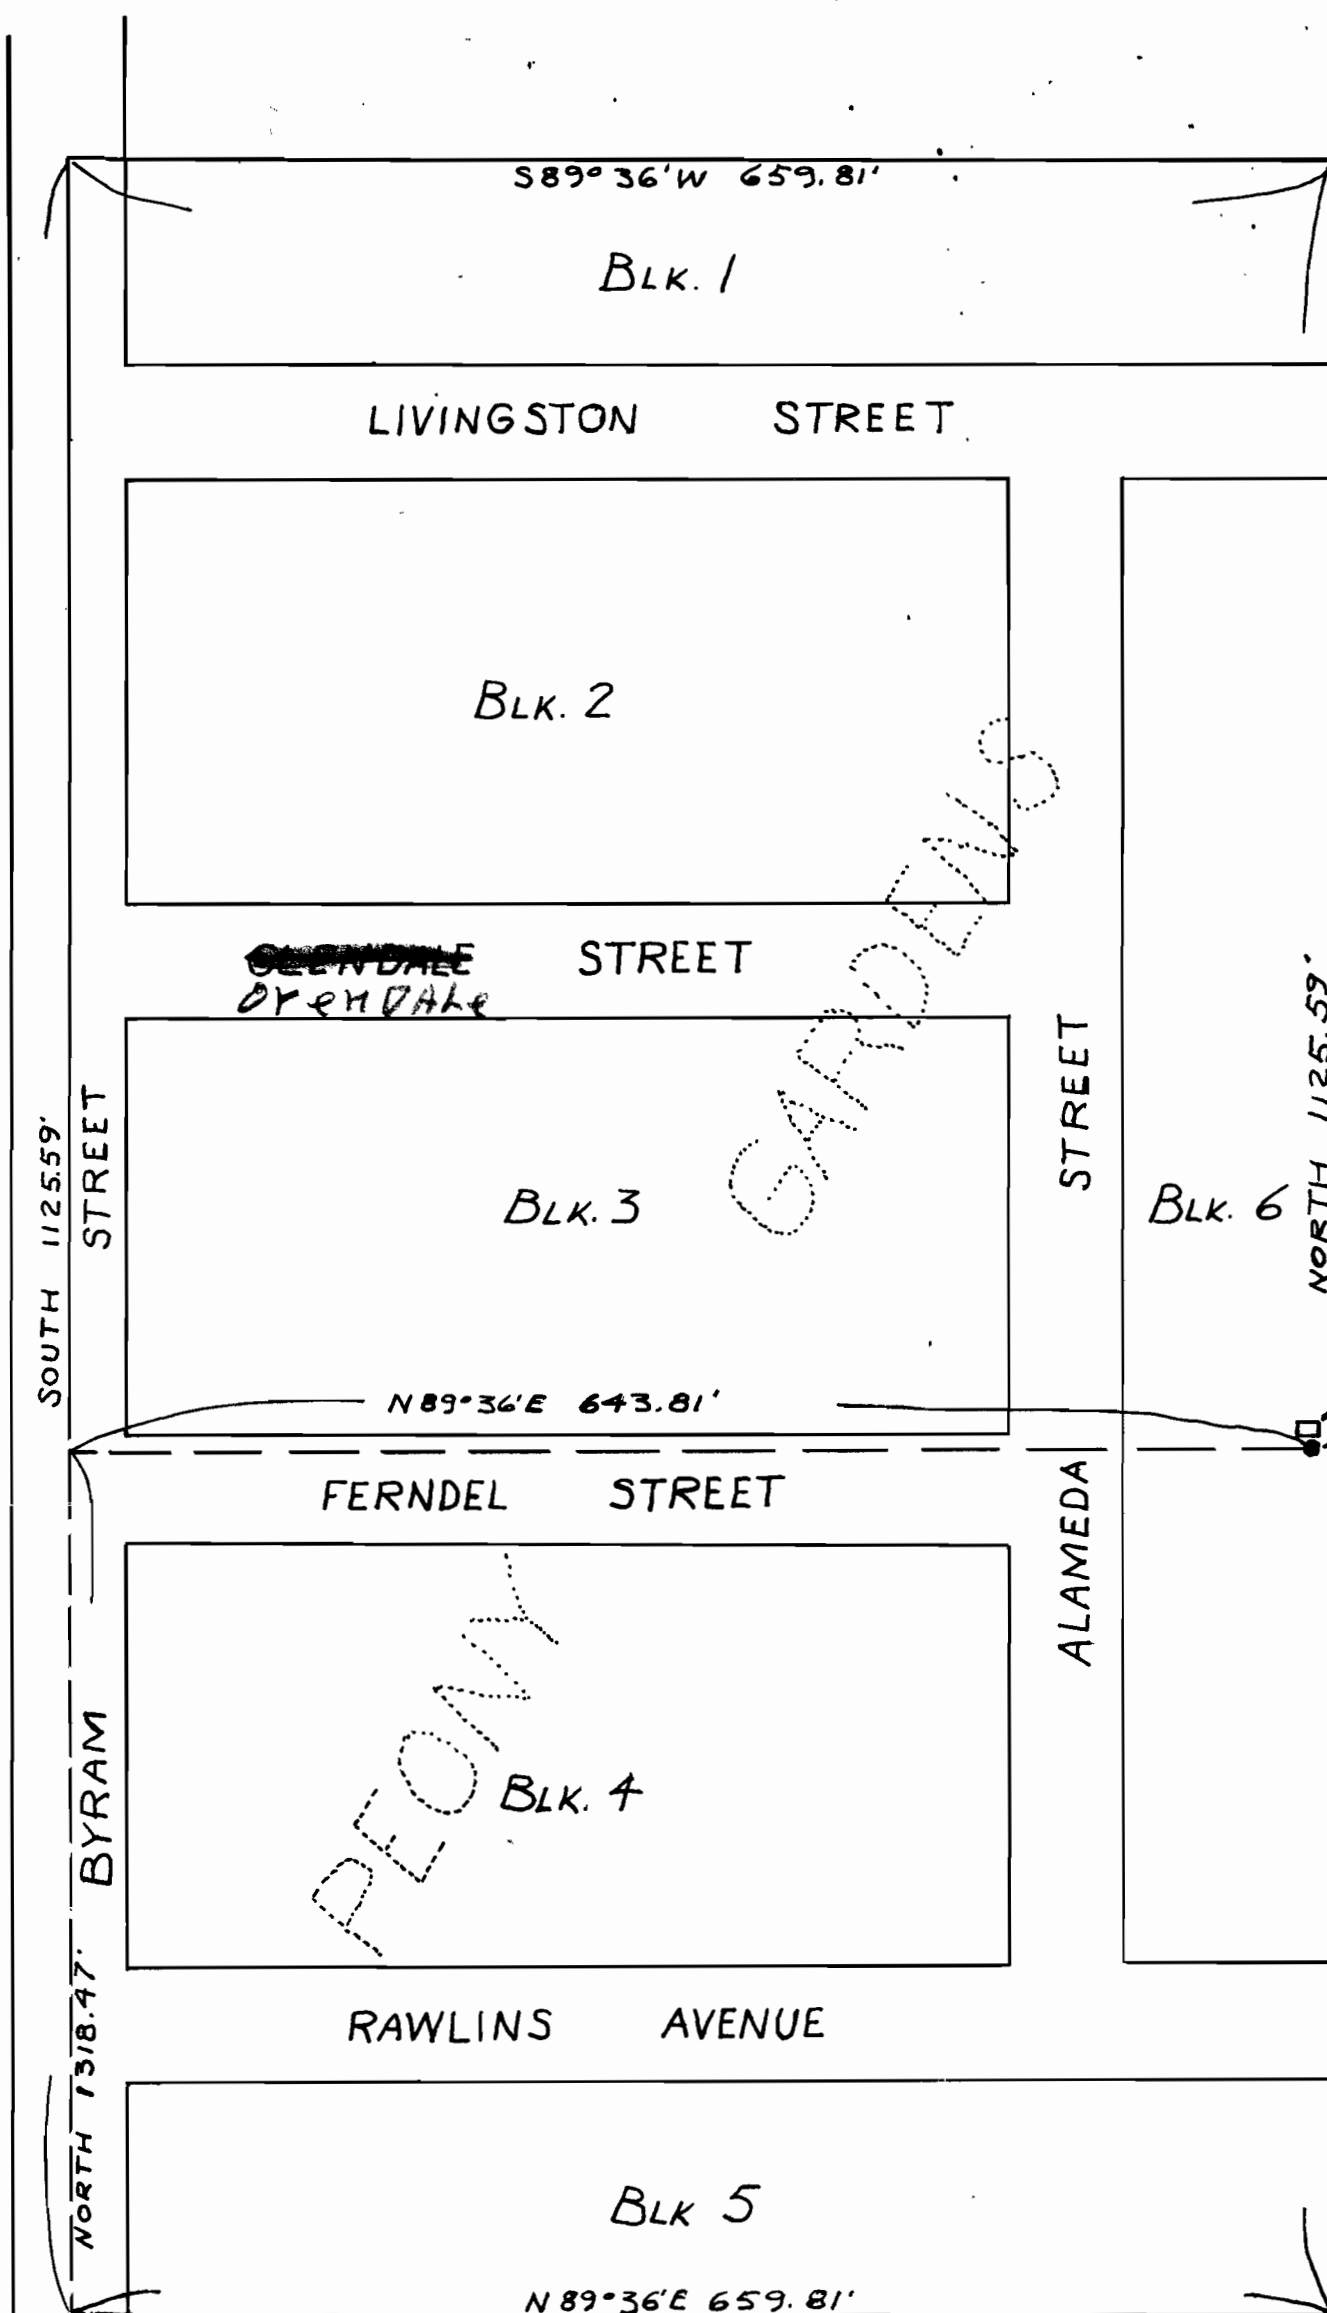

MAP TO ACCOMPANY GROUND WATER WELL LOCATION
 FOR
 ED. FISCHER
 IN SEC. 13 T7S, R3W, W.M. MARION CO, ORE.
 G. R. BOATWRIGHT ENGINEER
 SCALE 1" = 100'

9-11-56

S.E. COR. SAMUEL WALKER D.L.C.