


T. 7S. R. 3W. W.M.

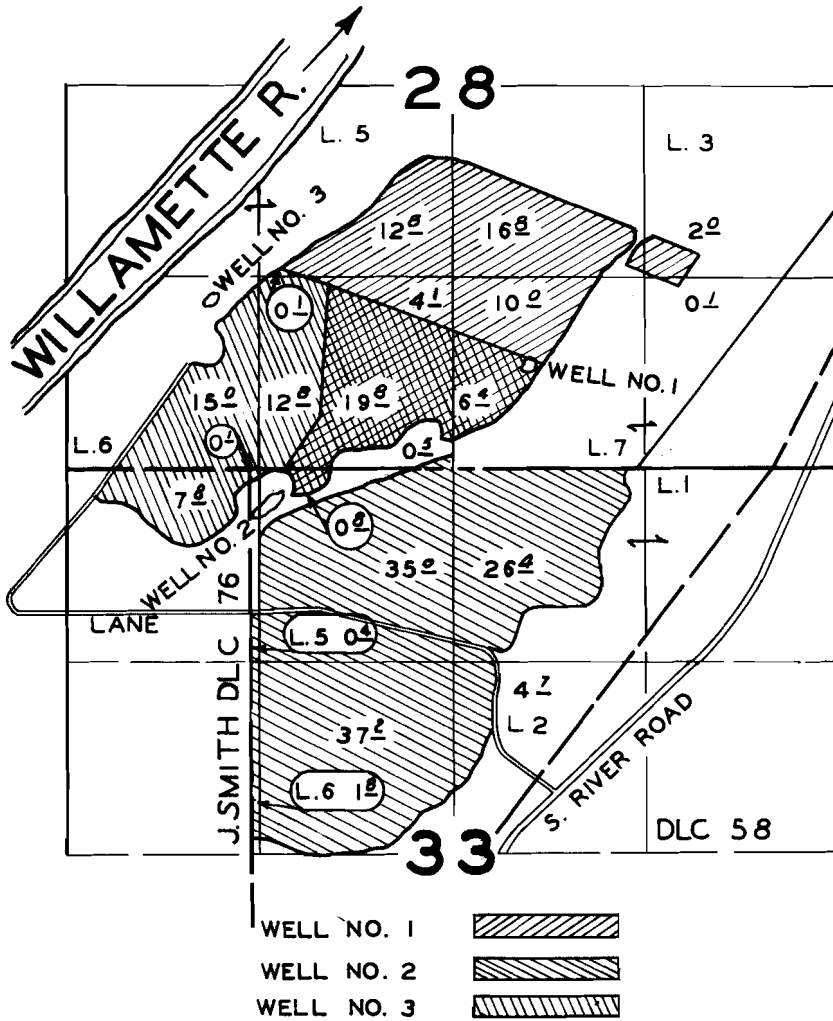

FINAL PROOF SURVEY
UNDER

Application No. G1602 Permit No. G1474
IN NAME OF

THEODORE , ARNOLD & TURFIELD SCHINDLER

Surveyed MAY 19 1960, by *[Signature]*