



T. 7S. R. 3W. W.M.

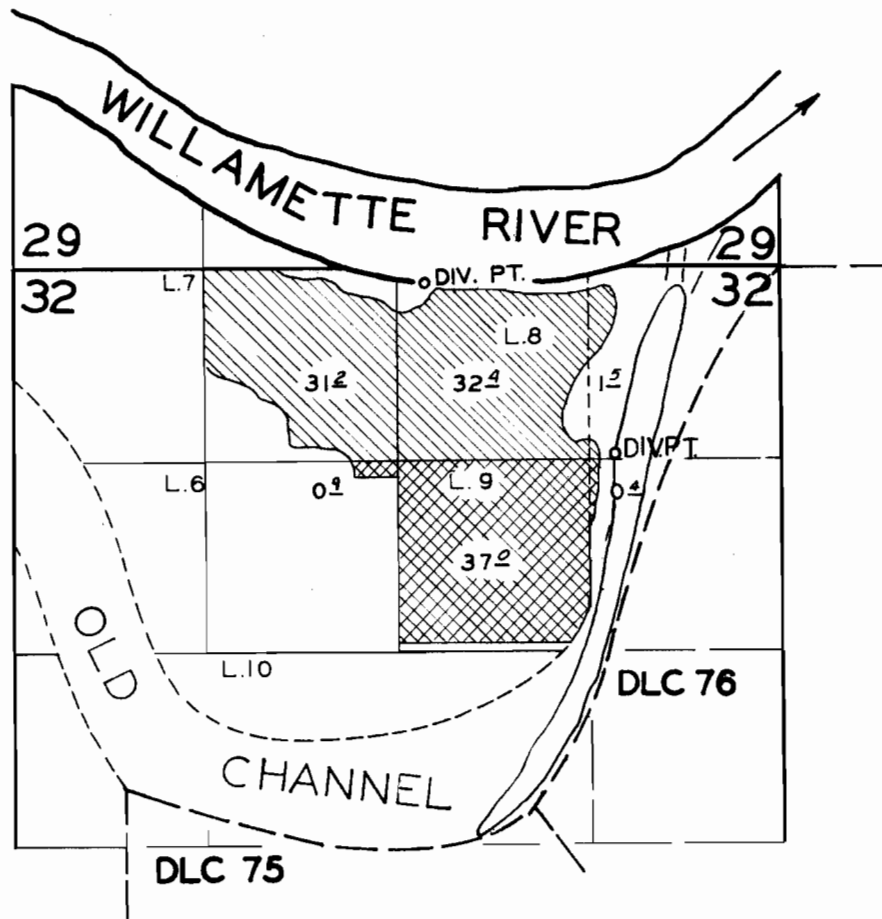

FINAL PROOF SURVEY
UNDER

Application No. 33420 (33974) Permit No. 26424 (26779) 
IN NAME OF

THEODORE & ARNOLD SCHINDLER

Surveyed MAY 19 1960, by *Appelton*