


T.5S.R.1W.W.M

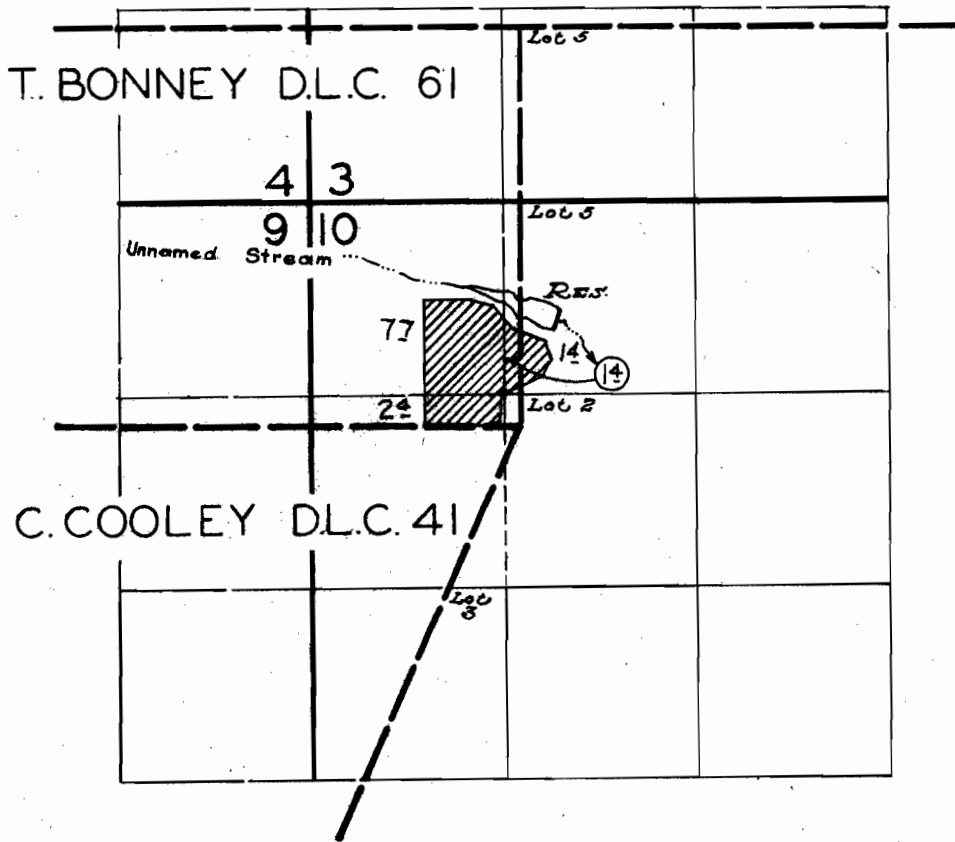

FINAL PROOF SURVEY UNDER

Application No. ^{R-52472} 32473 Permit No. ^{R-2158} 25640
IN NAME OF

JOHN McNULTY

Surveyed *June 2, 1960*, by *C.O. Barrels*