

WILLAMETTE




SECTION LINE

SECTION LINE

RIVER

SECTION 34  
Twp 1N, R1E, WM

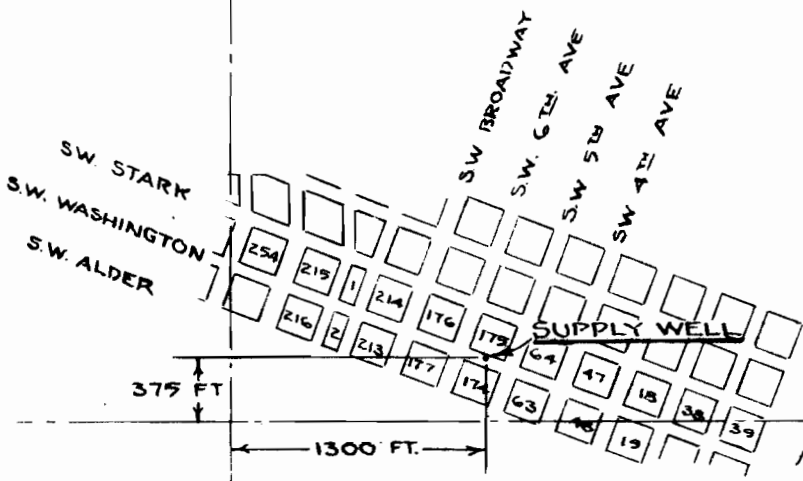

BURNSIDE ST.

SECTION LINE

### SUPPLY WELL LOCATION

FIRST NATIONAL BANK — MAIN BRANCH  
PORTLAND, OREGON

1" = 1000'-0"



Application No. G-866  
Permit No. G-768