


T. 1S. R. 3E. W.M.

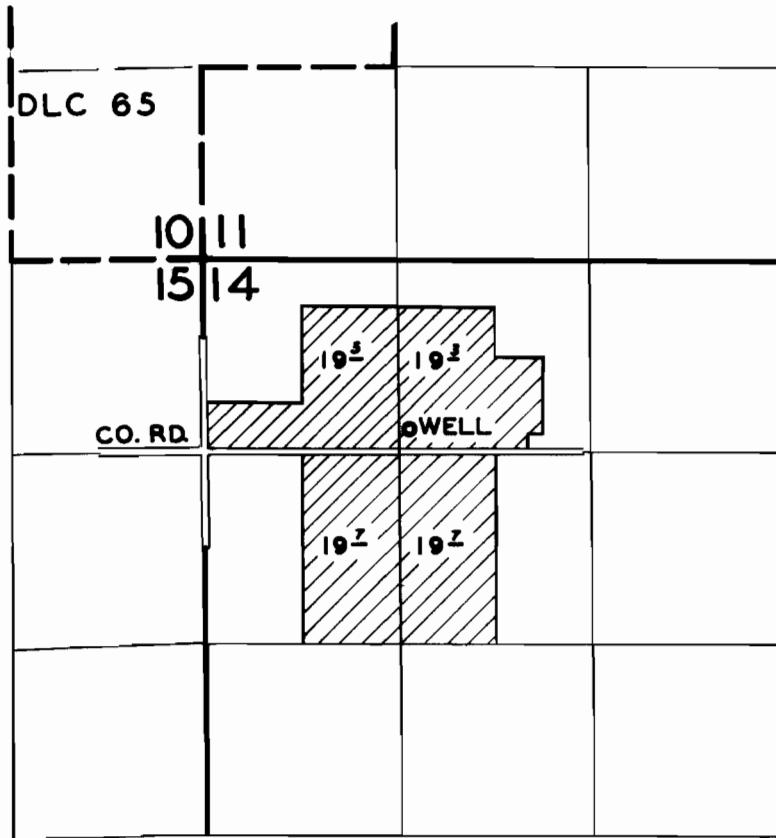

FINAL PROOF SURVEY UNDER

Application No. G1127 Permit No. G1046
IN NAME OF

MELVIN D. GRADIN

Surveyed MAY 10 19 60, by C.O. BARTELS