


T.6S.R.7W.W.M.

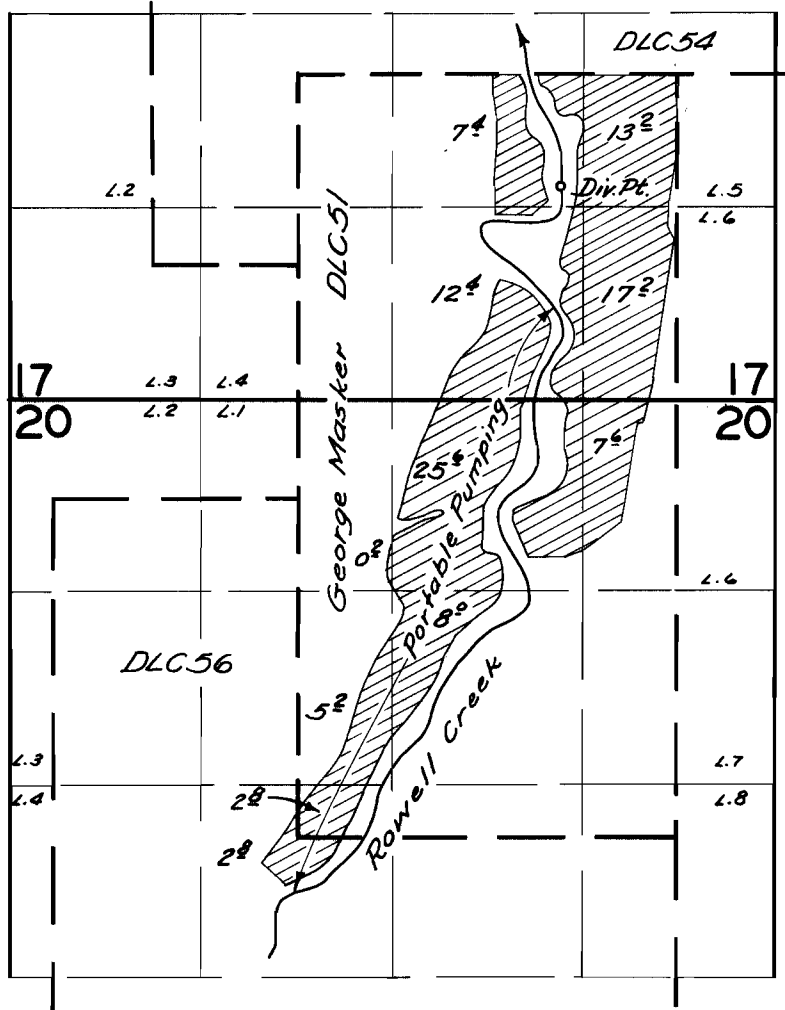

FINAL PROOF SURVEY UNDER

Application No. 29224 Permit No. 23925
IN NAME OF

Elwin Littlejohn

Surveyed June 22, 1960, by C.O. Birtala