


4-167
C-28952

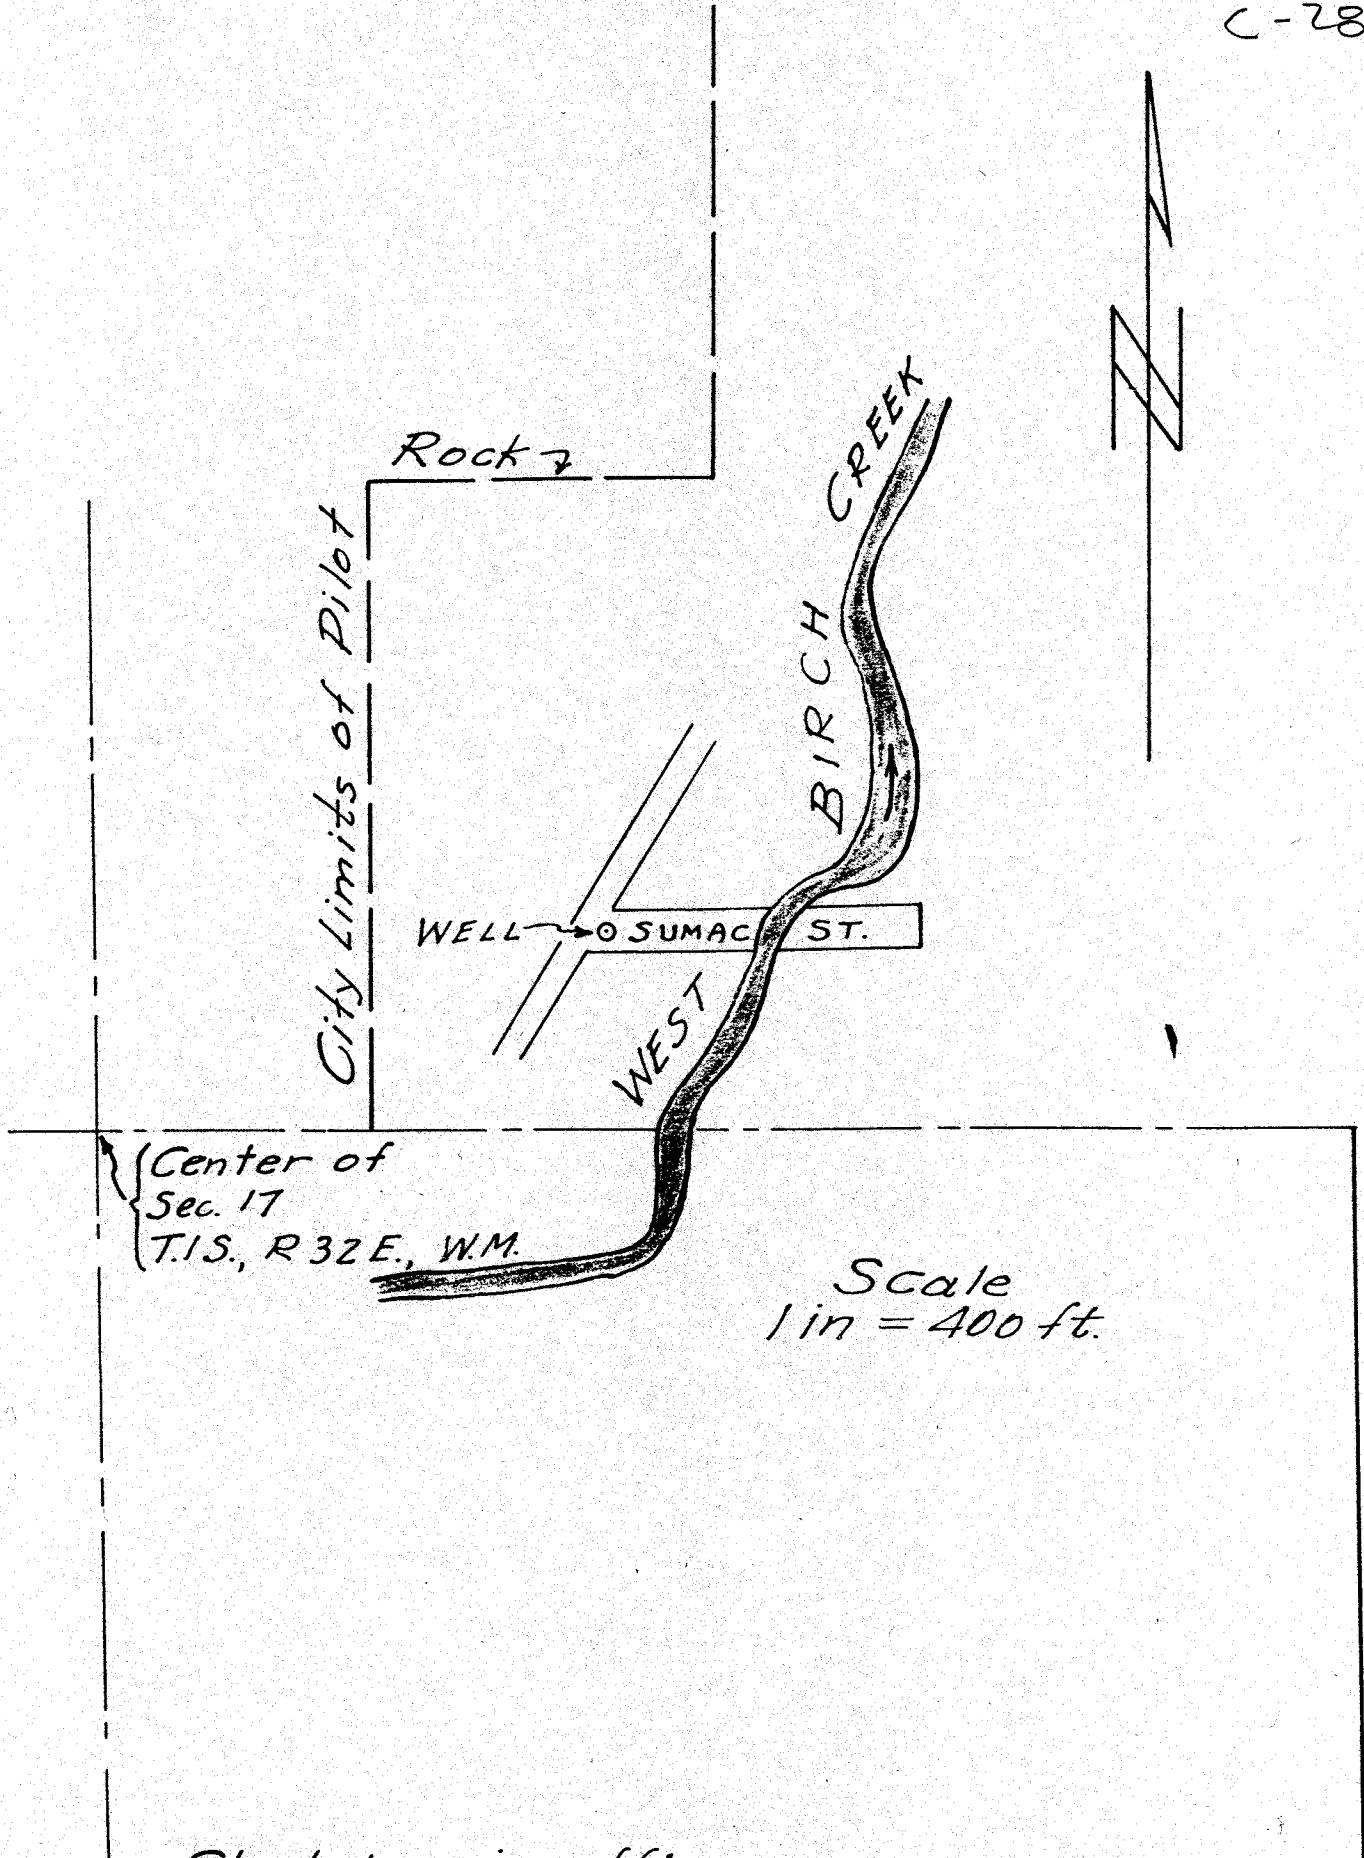

Sketched in office
of State Engineer
from Highway map
and data by applicant

Application No. 21-174
Permit No. 21-167