


U-211
C-28953

T.6N.R.35E.W.M.

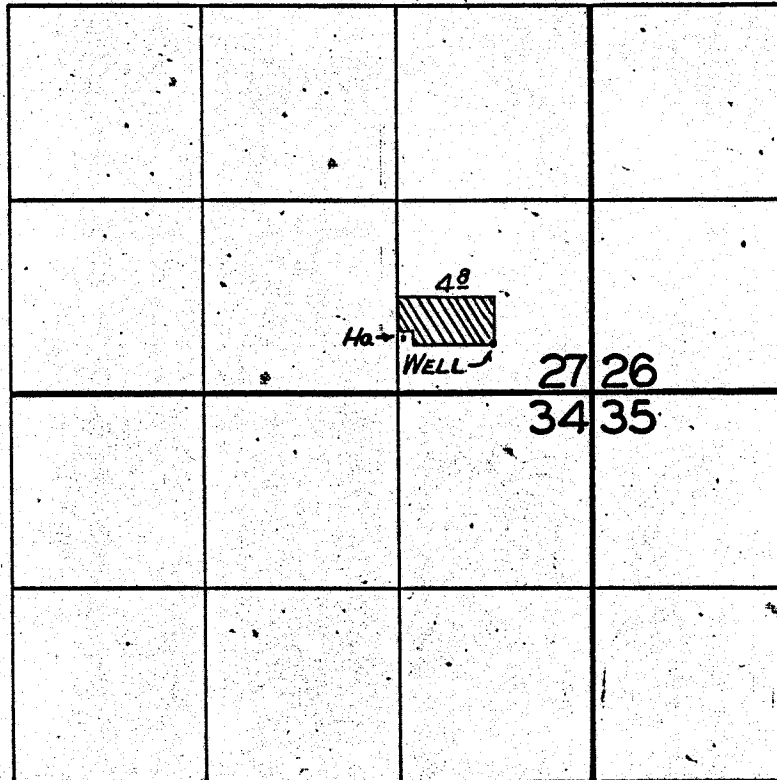

FINAL PROOF SURVEY UNDER

Application No. U-231 Permit No. U-211

IN NAME OF

Herschel & Fargn Tash

Surveyed July 13, 1960, by M. BISH

NZ-5F 62