


U-443
C-28954

T. 2N. R. 33E. W.M.

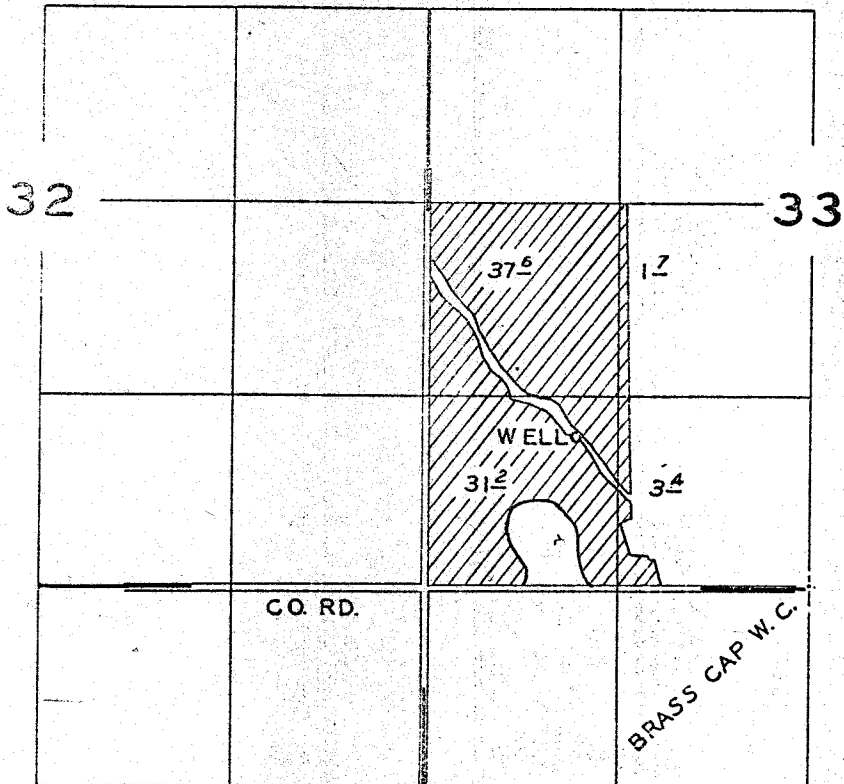

FINAL PROOF SURVEY UNDER

Application No. U 491 Permit No. U443
IN NAME OF

SOPHIA MULLER

Surveyed JULY 20 19 60, by [Signature]