
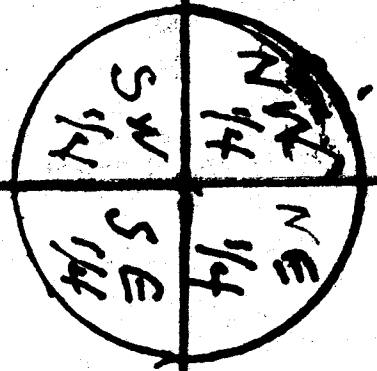
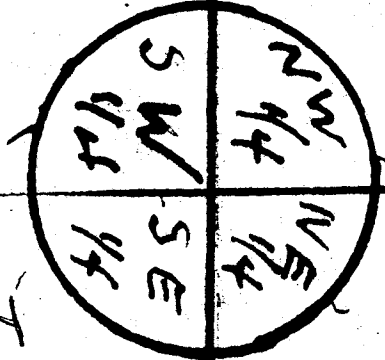


US STAKE
1 1/4" PIPE

850'

530'

T. 2 N. R. 35 E

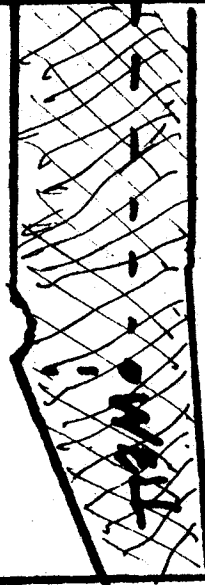

L-28955 Rev U-580
app U-630