


T.6N.R.35E.W.M.

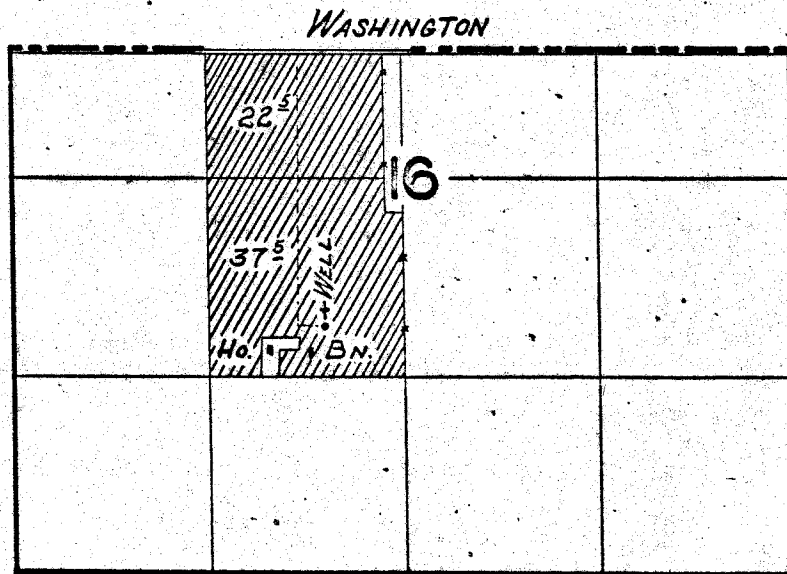

FINAL PROOF SURVEY UNDER

Application No. G-177 Permit No. G-87
IN NAME OF

WALDO G. GIESELMAN

Surveyed JULY 15 1960, by M. BISH